

R#138¹⁵

WATER SERVICE RECORD

Name E. Lester Goodrich

Service No. 65

Address 16 Summer Street

Location Lexington

Repair/Replacement - New Service

Com 6-16-52


Date	Material	Amount	Total	Date	Amount
5/22/52	Labor	30 60		4-22-52	600 00
5/23/52	"	64 22		6-16-52	138 15
5/26/52	"	22 95	117 77		NON CHARGE
	10% overhead		11 78	20'-1" copper tubing@.4048	8 09
	470' - 1" copper tubing@.4048		190 25	1 - 1" C. corp-cock	5 61
	1 - 1" Cx 1" I.W.H.stop&waste		5 12	1 - 1" C x 1" C. curb-cock	6 80
	6 - 1" Cx 1" C.unions @ 2.26		13 56	2 - 1" C x 1" I. unions@2.26	4 52
	600 brick @ 36.10 per M		21 66	1 box and rod	4 52
	1 - pit cover and frame		8 71	2 - 1" straight tail pcs.@.93	1 86
	9 hrs. Littlefield shovel		63 00	1 hr. trucking	75
	7 hrs. allis chalmers @ 3.00		21 00		
	1 hr. trailer		3 00		
	2 hrs. trucking @ 3.00		6 00		
			461 85		32 15

DATE _____

TOWN OF LEXINGTON — BOARD OF PUBLIC WORKS

WATER DIVISION

Sketch of Service Here

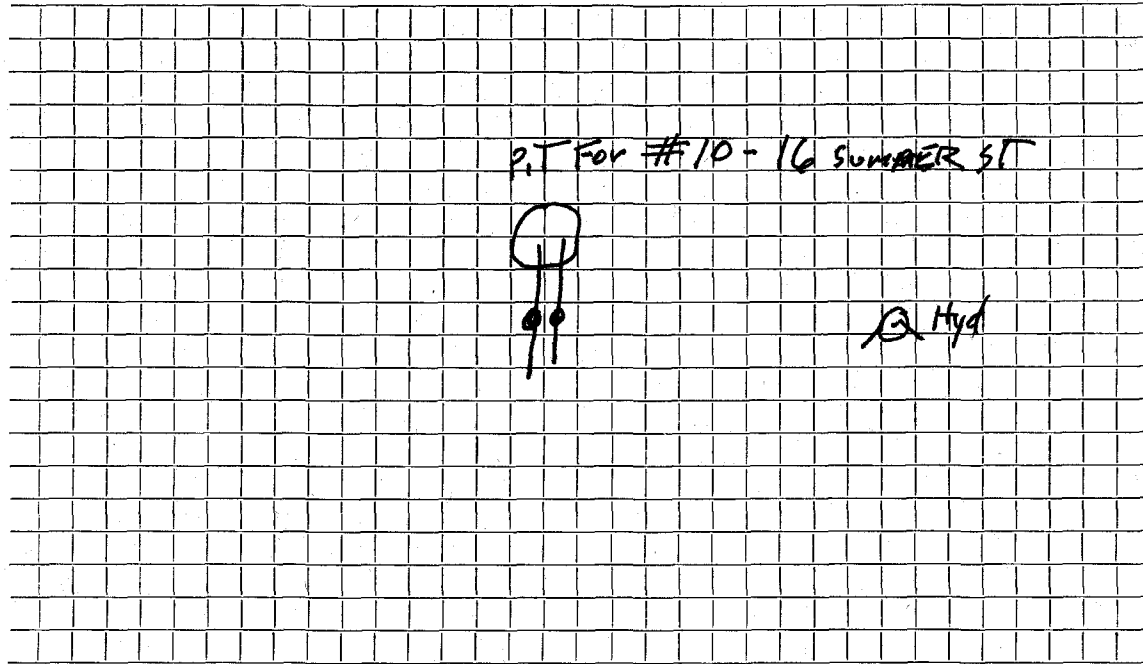

Connection made in SUMMER ST 16" MAIN Street. Work completed

Remarks: PIT IN DRIVEWAY NO 10A

.....
.....