

WATER SERVICE RECORD

Name John Campobasso

Service No. 66

Address 25 Summer Street,

Location Lexington, Mass.

~~XXXX-XXXX~~ - New Service

Com. 8-6-51


Date	Material	Amount	Total	Date	Amount
5/9/51	Labor	18 42	18 42	4-16-51	Deposited 125 00
	10% overhead		1 84		
	80' -3/4" copper tubing @ .326	26 08			No Charge
	1 - 3/4" Cx 1/2" I.W.H. stop&waste	4 00	5/10/51	Labor	24 97
	1 - 3/4" Cx 3/4" C. union (3pts.)	1 72		33' -3/4" copper tubing @ .326	10 76
	4 hrs. Littlefield shovel @ 7.00	28 00		1 - 3/4" C. corp-cock	4 33
	1 hr. trucking		75	1 - 3/4" C x 3/4" C. curb-cock	4 67
	patching 22x3		22 00	1 - box and rod	4 68
			102 81	1 - 1/2 offset tail piece	50
				1 - 1/2 straight tail piece	50
				4 2/3 hrs. Littlefield shovel @ 7.	32 66
				1 hr. trucking	75
					83 82

DATE _____

TOWN OF LEXINGTON — BOARD OF PUBLIC WORKS

WATER DIVISION

Sketch of Service Here

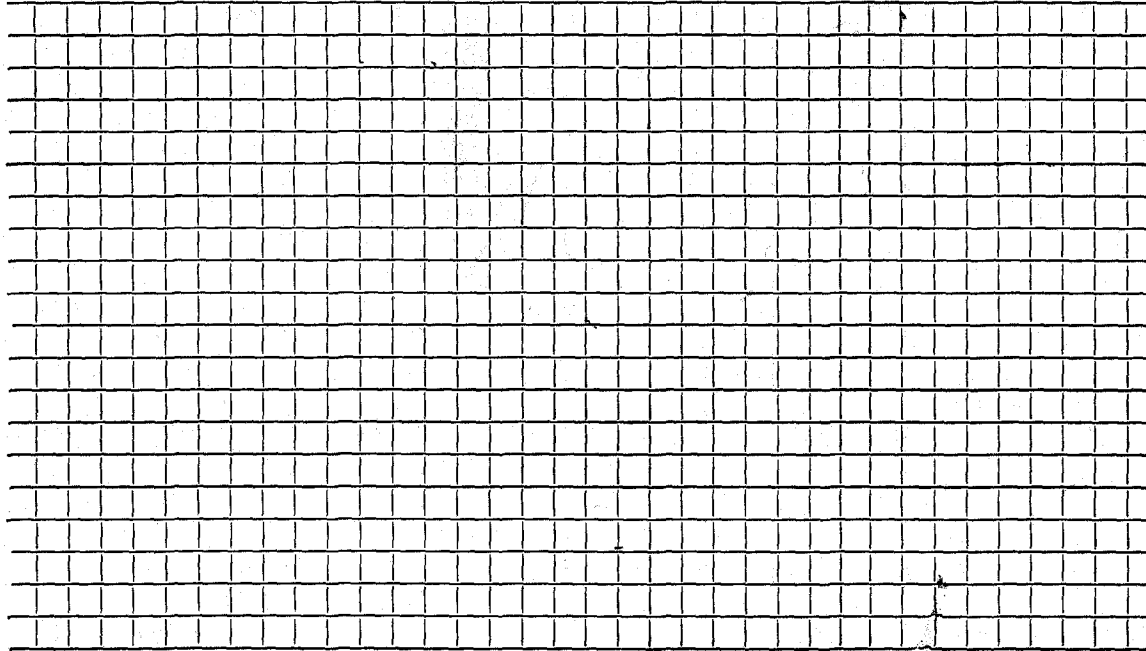

Connection made in Street. Work completed

Remarks:

.....

.....