


DATE MARCH 17 1998

TOWN OF LEXINGTON — BOARD OF PUBLIC WORKS

WATER DIVISION

Sketch of Service Here

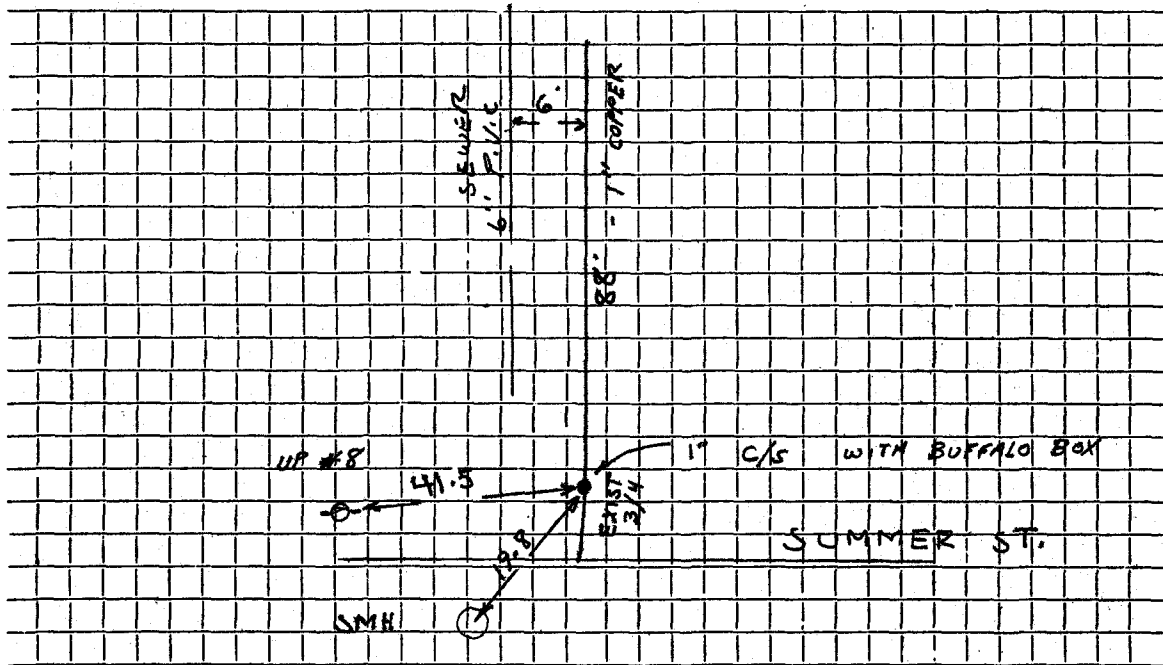

Connection made in SUMMER ST. Street. Work completed J.M. McLAUGHLIN

Remarks: NO FOUNDATION IN AT TIME OF INSPECTION

FIELD BOOK 98-1


TJM

DATE _____

TOWN OF LEXINGTON — BOARD OF PUBLIC WORKS

WATER DIVISION

Sketch of Service Here

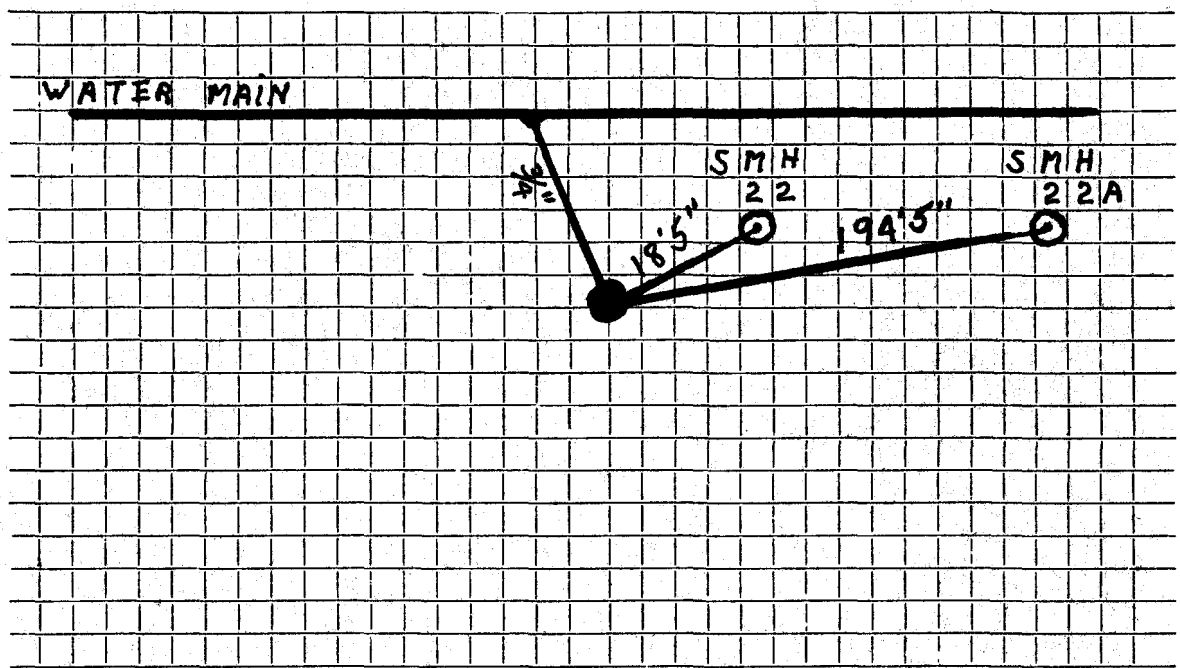

Connection made in Street. Work completed

Remarks:
.....
.....