




DATE MARCH 25 1998

TOWN OF LEXINGTON — BOARD OF PUBLIC WORKS  
WATER DIVISION

Sketch of Service Here

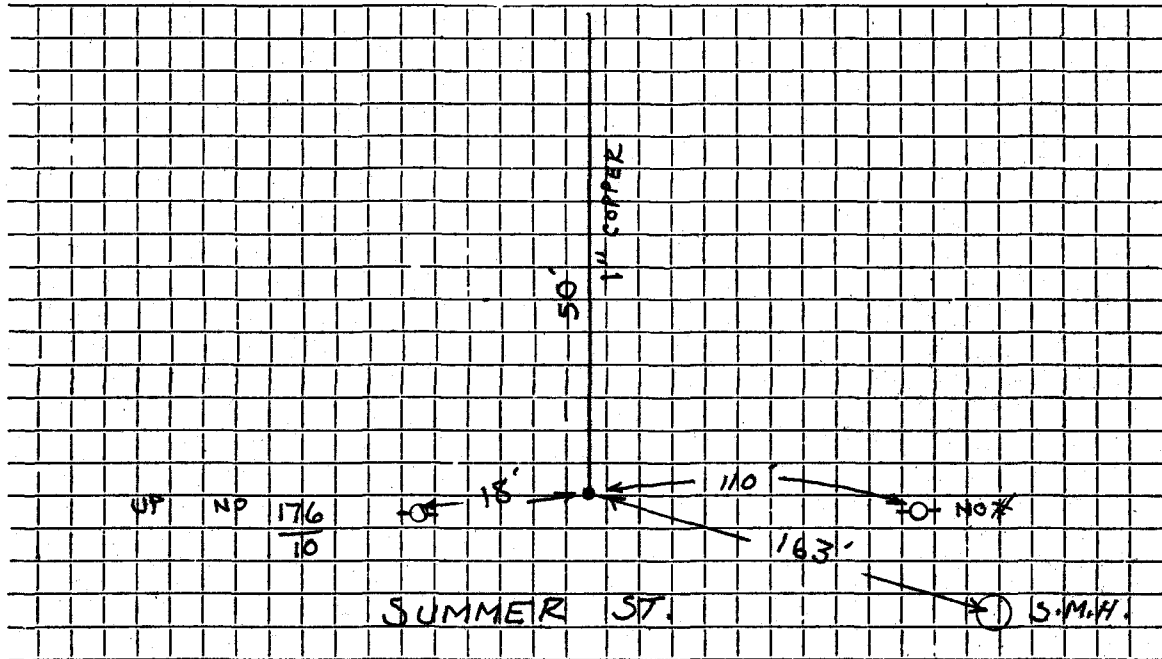

Connection made in .SUMMER...ST..... Street. Work completed .J.M. MCLAUGHLIN.....  
Remarks: .....NO FOUNDATION IN AT TIME OF INSPECTION.....

FIELD BOOK 98-1

TJM

WATER SERVICE RECORD

Name

Service No.

Address 33 SUMMER STREET (LOT #3)

Location

~~Repair~~ ~~Renewal~~ New Service


Date	Material	Amount	Total	Date	Amount
<del>10-0-75 11-74 21-75 410.00</del>					
				10-18-75	
	41' 3/4" Copper				
	1 3/4" Corp Cock				
	1 3/4" Curb Cock				
	1 Box + Rod				

DATE \_\_\_\_\_

# TOWN OF LEXINGTON — BOARD OF PUBLIC WORKS

## WATER DIVISION

Sketch of Service Here

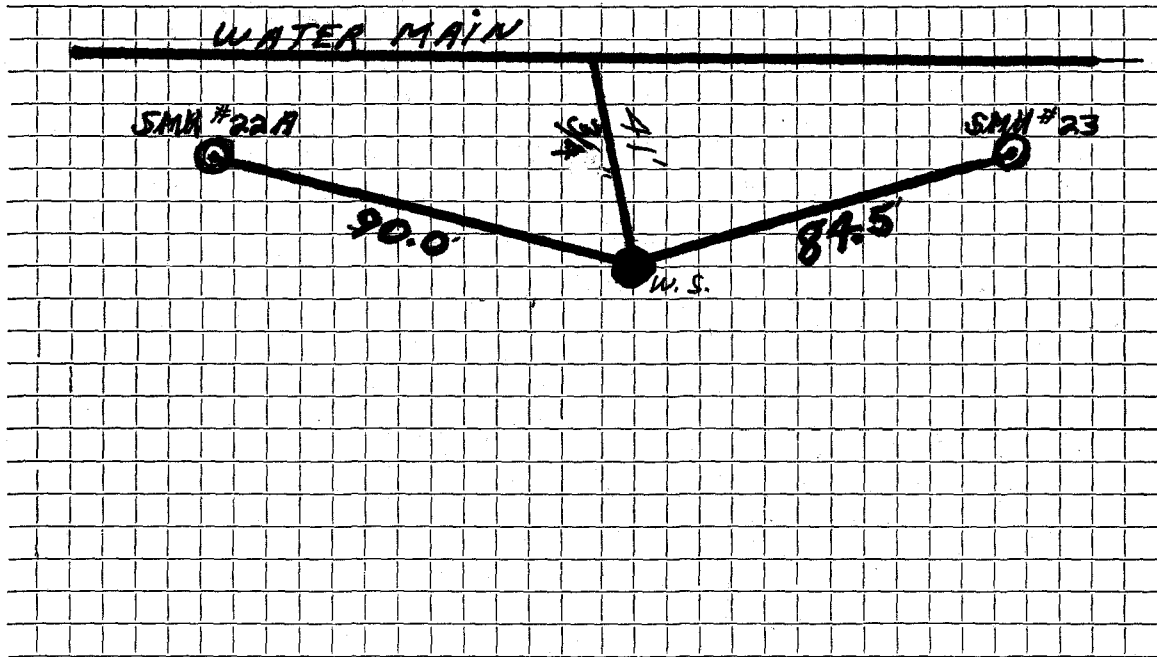

Connection made in S.U.M.M.E.R. Street. Work completed .....

Remarks: .....  
.....  
.....