

## WATER SERVICE RECORD

Name

Service No.

Address

35 SUMMER STREET (LOT # 4)

Location

Repair—Renewal—New Service


Date	Material	Amount	Total	Date	Amount
<del>2-25-75</del>	<del>32' 3/4" Copper</del>	<del>10.00</del>	<del>3.00</del>		
				9-29-'75'	
				32' 3/4" Copper	
				1 3/4" C. Corp Cock	
				1 3/4" C. Curb Cock	
				1 Box + Rod	

DATE \_\_\_\_\_

TOWN OF LEXINGTON — BOARD OF PUBLIC WORKS

WATER DIVISION

Sketch of Service Here

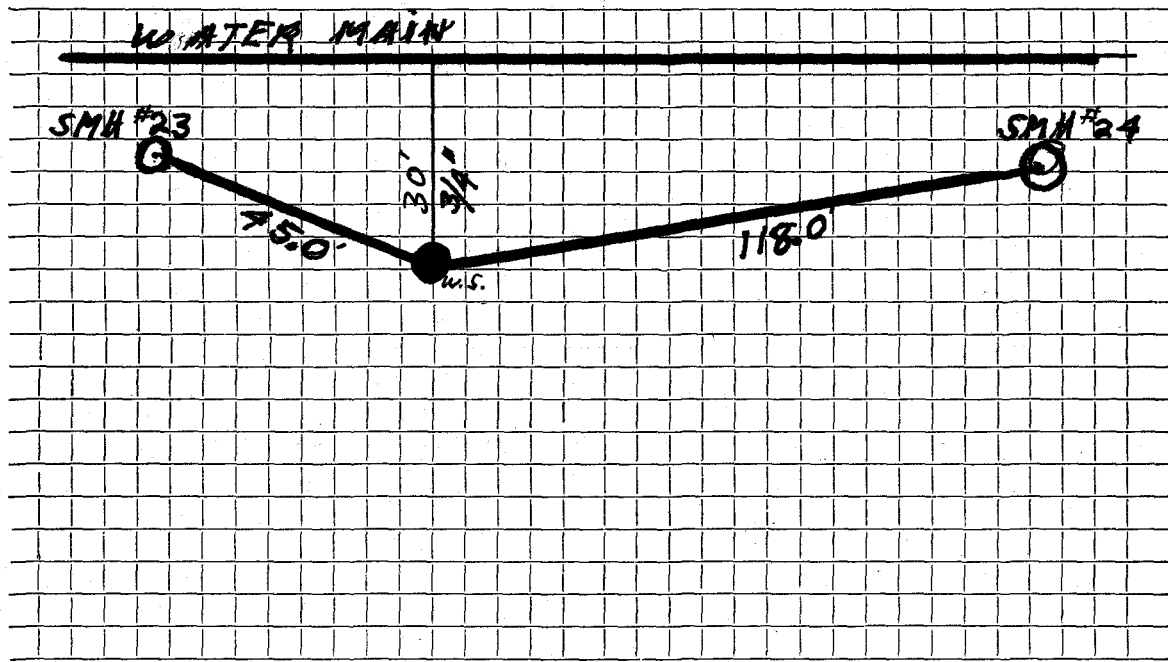

Connection made in SUMMER Street. Work completed .....

Remarks: .....  
.....  
.....