

WATER SERVICE RECORD

Name Joseph Comeiro

Service No. 31

Address 36 Summer St.

Location

*Repair—Renewal—New Service W.O.#6973 DeFlice #118

NOV 18 1968


| Date | Material | Amount | Total | Date | Amount |
|---------|-----------------------|--------|--------|----------|--------|
| 6/27/68 | Labor | 55 80 | | 7-16-68 | 230 00 |
| 7/3/68 | " | 20 92 | | 11-18-68 | 67 67 |
| | 10% O.H. | 7 67 | 84 39 | | 162 33 |
| 15' | 1" copperpipe @ .99 | | 14 85 | | |
| 1 | 1" corporation | | 10 66 | | |
| 1 | curb cock | | 14 43 | | |
| | Box & Rod | | 5 10 | | |
| 2 | Hrs. shovel @ 6.50 | | 13 00 | | |
| 3 | " truck @ 3.00 | | 9 00 | | |
| 1/2 | " roller @ 3.00 | | 1 50 | | |
| | Trailer | | 2 00 | | |
| 1/2 | " compressor @ 5.00 | | 2 50 | | |
| 1/2 | " loader @ 4.00 | | 2 00 | | |
| 1/2 | Ton hot top @ 5.80 | | 2 90 | | |
| | | | 162 33 | | |
| 7-19-68 | 174' 1" Copper tubing | | | | |

DATE _____

TOWN OF LEXINGTON — BOARD OF PUBLIC WORKS

WATER DIVISION

Sketch of Service Here

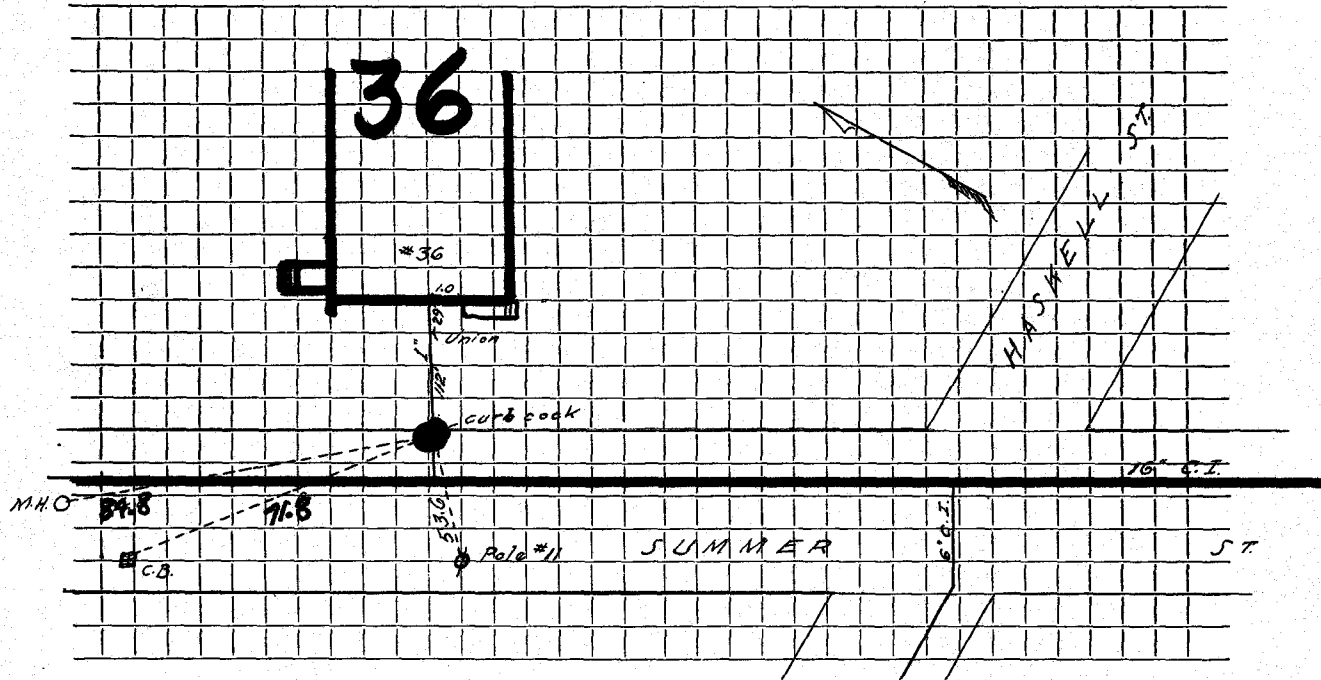

Connection made in Street. Work completed

Remarks:
.....
.....