

WATER SERVICE RECORD

Name

Service No.

Address

37 SUMMER STREET (LOT #6)

Location

Repair—Renewal—New Service


Date	Material	Amount	Total	Date	Amount
9-25-75	37' 3/4"	1	37' 3/4"		
				9-25-'75	
	37' 3/4" Copper	1			
	1 3/4" Corp Cock	1			
	1 3/4" Curb Cock	1			
	1 Box + Rod				

DATE _____

TOWN OF LEXINGTON — BOARD OF PUBLIC WORKS

WATER DIVISION

Sketch of Service Here

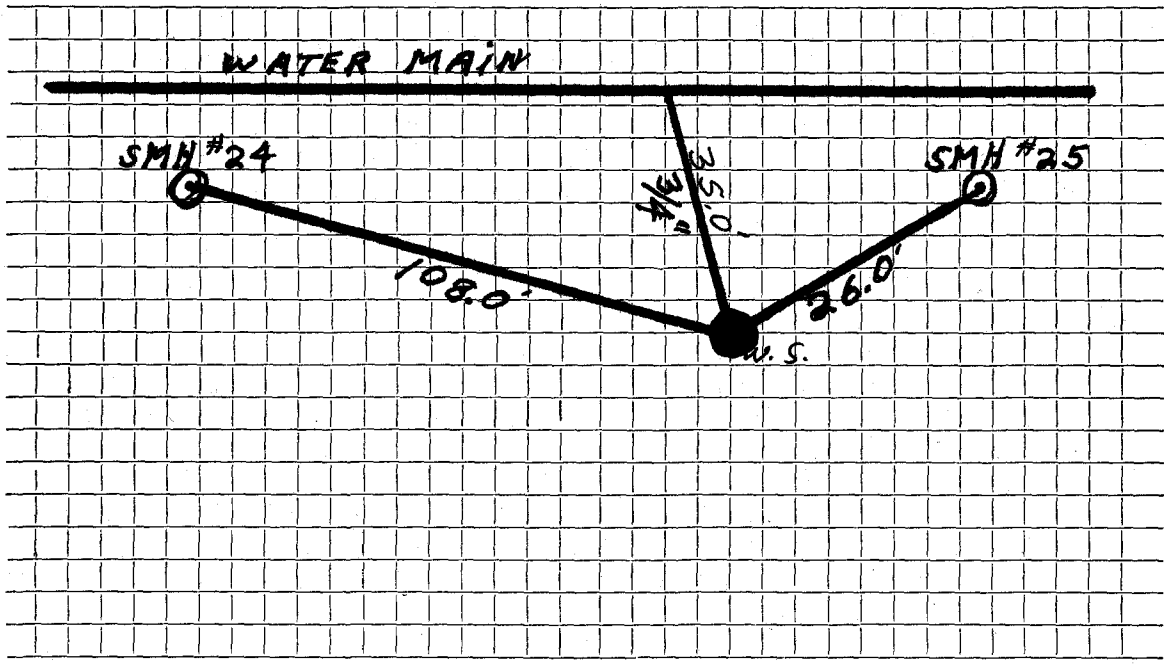

Connection made in SUMMER Street. Work completed

Remarks:
.....
.....