




# TOWN OF LEXINGTON — BOARD OF PUBLIC WORKS

## WATER DIVISION

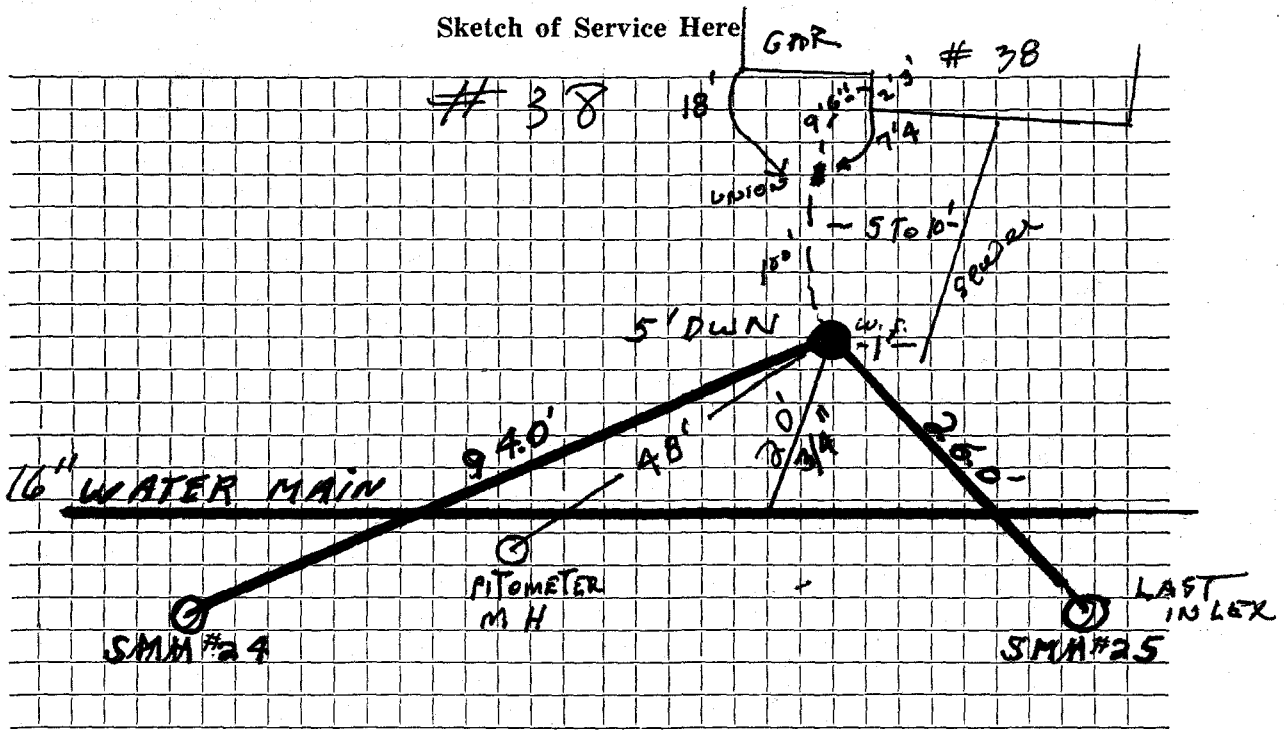

Connection made in SUMMER..... Street. Work completed .....

Remarks: .....

.....

.....