


DATE _____

TOWN OF LEXINGTON — BOARD OF PUBLIC WORKS
WATER DIVISION

Sketch of Service Here

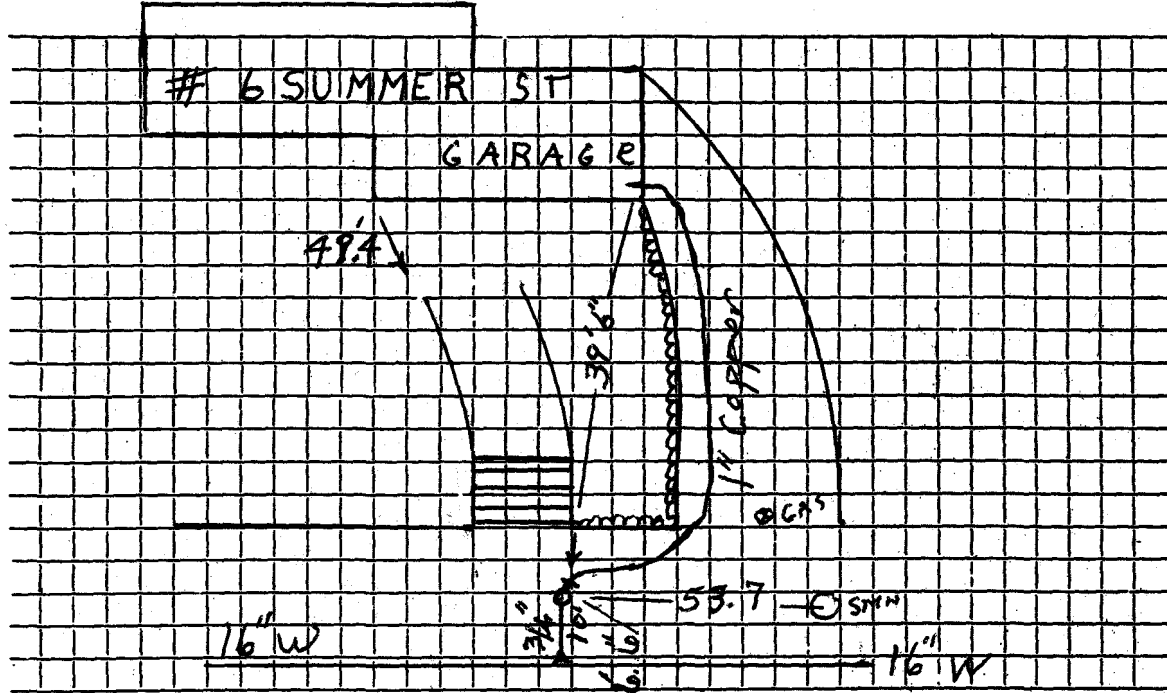

Connection made in Street. Work completed 1/26/07

Remarks: 1" copper approx. 3' off wall in driveway. CO 176/2

..... GAS 1" N. DRIVEWAY