

DATE _____


TOWN OF LEXINGTON — BOARD OF PUBLIC WORKS

WATER DIVISION

Sketch of Service Here

NO 7

~~##~~ ~~##~~ SUMMER SIT

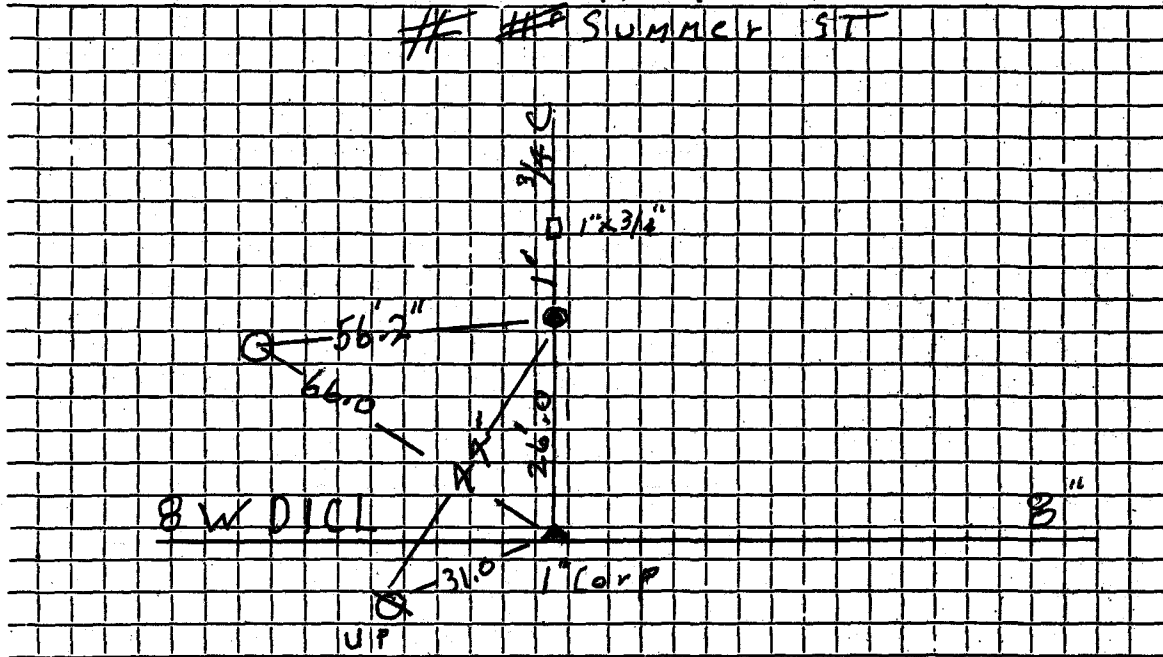

Connection made in Street. Work completed 7/7/06 Cedvone

Remarks: Tap on Lowell St