

Name

Service No. 2598

Address 12 Summit Road

Location

12 Summit Road.

Kind of Pipe

Size

Size of Main

~~Repair~~—Renewal—~~New Service~~ CURB TO MAIN

Work Order # 6784

Location

Date	Material	Amount	Total	Date	Amount
5/28/68	Labor		73 76		
5/28/68	8' 1" copper tubing @.99	7 92			
	1 1" Corp. Adapter	10 66			
	1 1" Curb stop	10 80			
	1 1 1/4" lead lined coupling	86			
	1 Box and Rod	5 10			
	1 ton hot top	5 80			
	1 load gravel	1 10			
	8 hrs. Back Hoe @6.50	52 00			
	5 hrs. Trucking @3.00	15 00			
		Total - - -	\$183 00		
	Labor				

DATE _____

TOWN OF LEXINGTON—BOARD OF PUBLIC WORKS

WATER DIVISION

The undersigned applies for a supply of water at No. _____ St. and hereby agrees to comply with the rules and regulations as now, or at any future time, established by the Board of Selectmen.

Am't. of Estimate \$ _____

Owner

Dudley Murphy


Am't. Paid \$ _____

Address

12 Summit Road

Builder _____

Sketch of Service Here

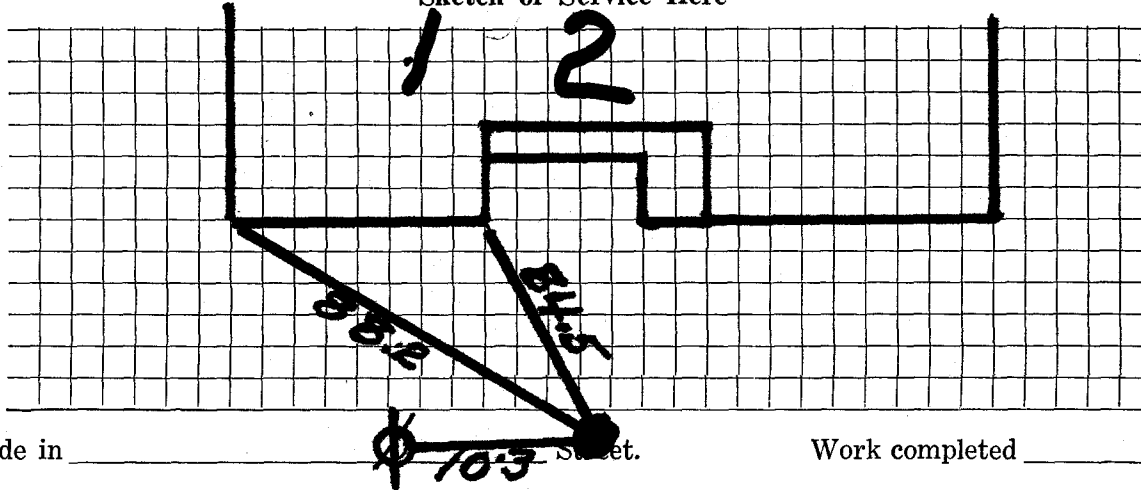

Connection made in _____

Work completed _____

19

Remarks: