

WATER SERVICE RECORD

Name

Service No.

Address

Location 2 Summit Road

Repair—Renewal—New Service


Date	Material	Amount	Total	Date	Amount
12-7-46					
179	1" Copper				
	1 1" C. X 3/4" I. W.H. Stop + Waste			12-5-46	
	2 1" C. X 1" I. 3 Part Union				
					9' 1" Copper
					1 1" C. Corp Cock
					1 1" C. X 1" C. Curb Cock
					1 Box + Rod

DATE _____

TOWN OF LEXINGTON — BOARD OF PUBLIC WORKS

WATER DIVISION

Sketch of Service Here **2**

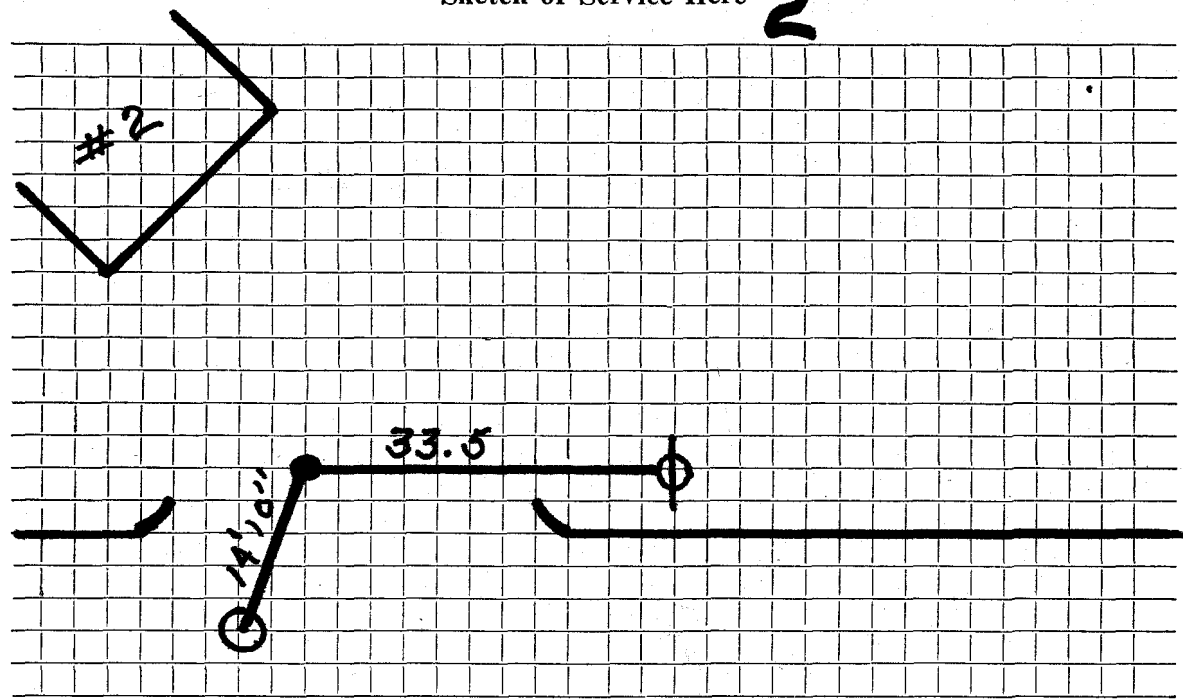

Connection made in Street. Work completed

Remarks: *Curb in Street Gate Box - Open left, Shut right.*