

WATER SERVICE RECORD

Name

1047
Service No. 2599

Address 21 Summit Road

Location

Repair—Renewal—New Service


Date	Material	Amount	Total	Date	Amount
8-2-'32'				4.28.92	
	59' 1" C.L. Pipe			18'6"	3/4 Copper
	3 1" L.L. Coupling			6"	Saddle 3/4" tap
	1 1" L.L. ELL				3/4" compression corp
	1 Stop + Waste				3/4" compression curb
					1" to 3/4" iron to copper
					compression adapter
					1 box & rod

DATE _____

TOWN OF LEXINGTON — BOARD OF PUBLIC WORKS

WATER DIVISION

Sketch of Service Here

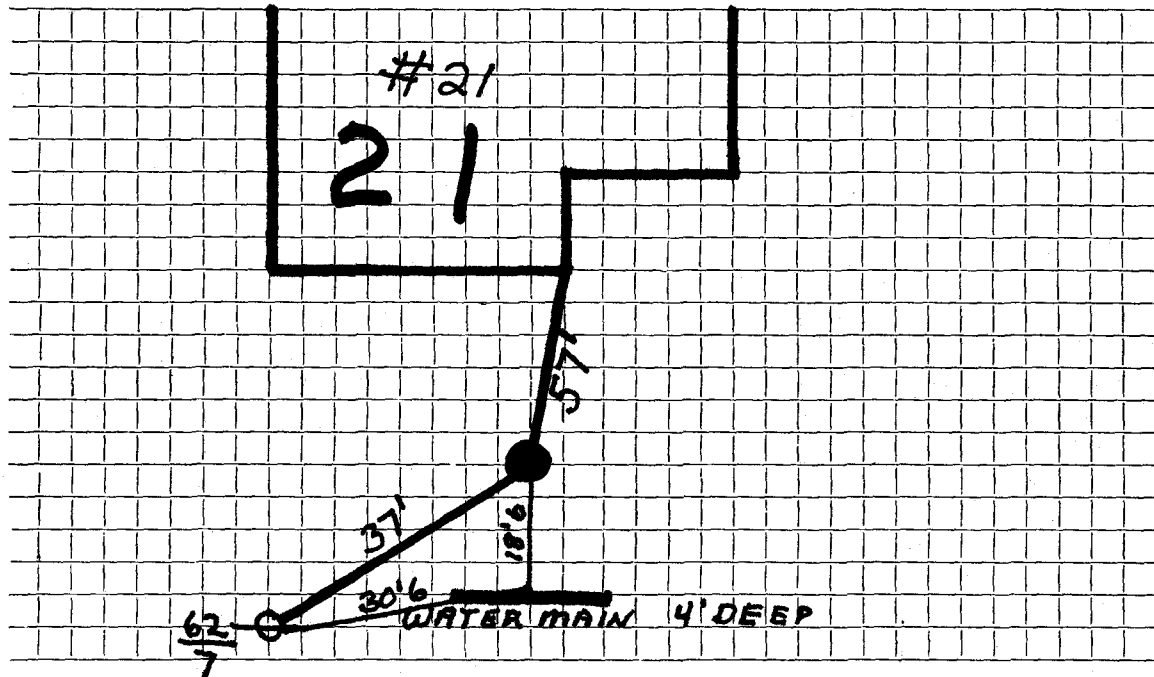

Connection made in Street. Work completed

Remarks:

.....

.....