

WATER SERVICE RECORD

Name ALLEN Chamberlain

Service No. 2600

Address 22 Summit Rd

Location 22 Summit Rd

Repair—Renewal—New Service

Date	Material	Amount	Total	Date	Amount
Nov 26	73' 1 1/4" C.L.P.P.				
	3 1 1/4" LL Couplings				
July 30 5	130' 1 1/4" copper Pipe				
	1 1 1/4" Coupling				

Name Allen Chamberlain

Service No. ~~900~~ 2600

Address ~~30 Pinckney St., Boston~~ Service to house on Summit Road ²²

22 Summit Rd Location *22 Summit Rd.*

Kind of Pipe Size Size of Main

~~Repair-Renewal~~ New Service

Location

Date	Material	Amount	Total	Date	Amount
<i>11/24</i>	<i>P.</i>				
	73' 1 1/4" C.L. Pipe @ .35	25 55			
	3 1 1/4" L.L. Couplings @ .40	1 20			
	1 1 1/4" x 1" L.L. "	40			
	1 1" Brass S. Nipple	30			
	Trucking	1 25	28 70		
	Total Labor		1 20		
	15% Overhead		18		
			30 08	<i>Jan. 17 1927</i>	<i>Cash 30 08</i>
	Labor				
11/15/26	2 Hrs. @ .60	1 20			

The Bailey Press, Boston

WATER SERVICE RECORD

Name *ALLEN CHAMBERLAIN*

Service No. *2600*

Address *22 SUMMIT RD*

Location *22 SUMMIT RD*


Repair—Renewal—New Service

Date	Material	Amount	Total	Date	Amount
<i>NOV 26</i>	<i>73' 1 1/4" C.I.P.P.</i>				
	<i>3 1 1/4" LL Couplings</i>				
<i>JULY 305</i>	<i>130' 1 1/4" COPPER PIPE</i>				
	<i>1 1 1/4" COUPLING</i>				

DATE _____


TOWN OF LEXINGTON — BOARD OF PUBLIC WORKS

WATER DIVISION

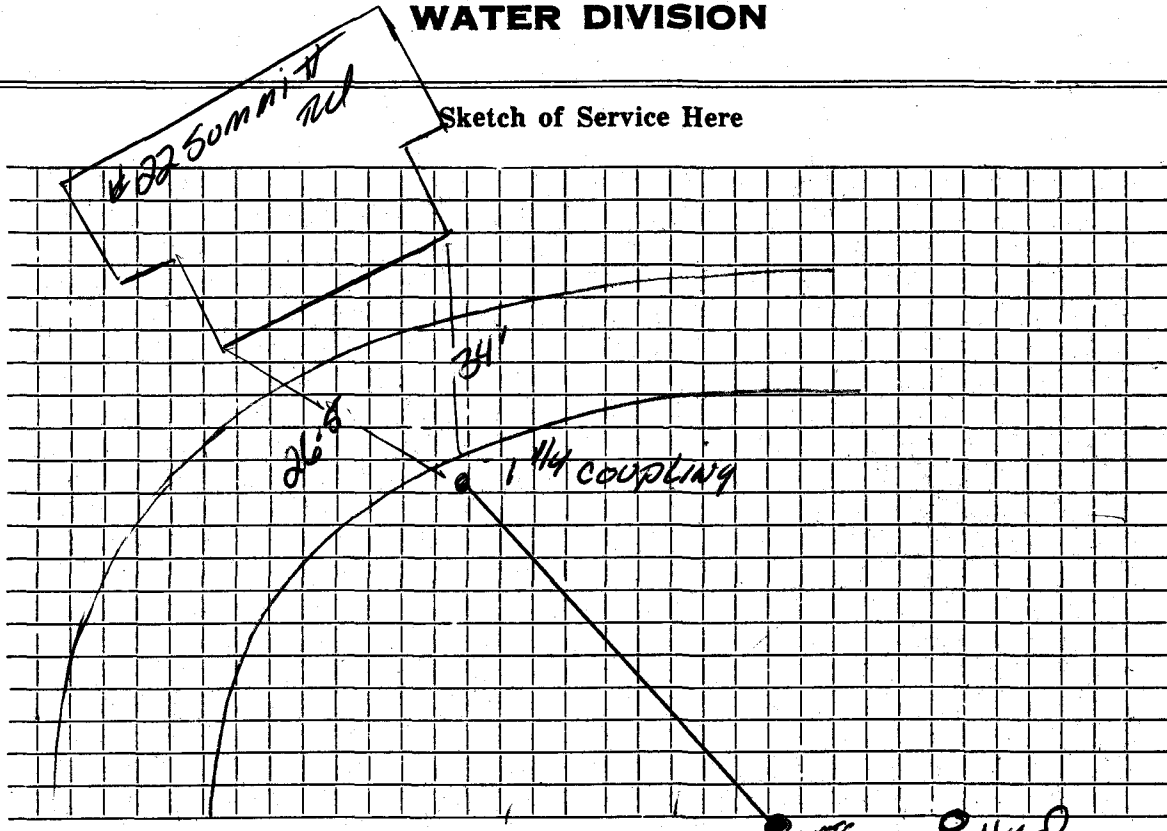

Connection made in Street. Work completed *GATE* *442*

Remarks:
.....
.....

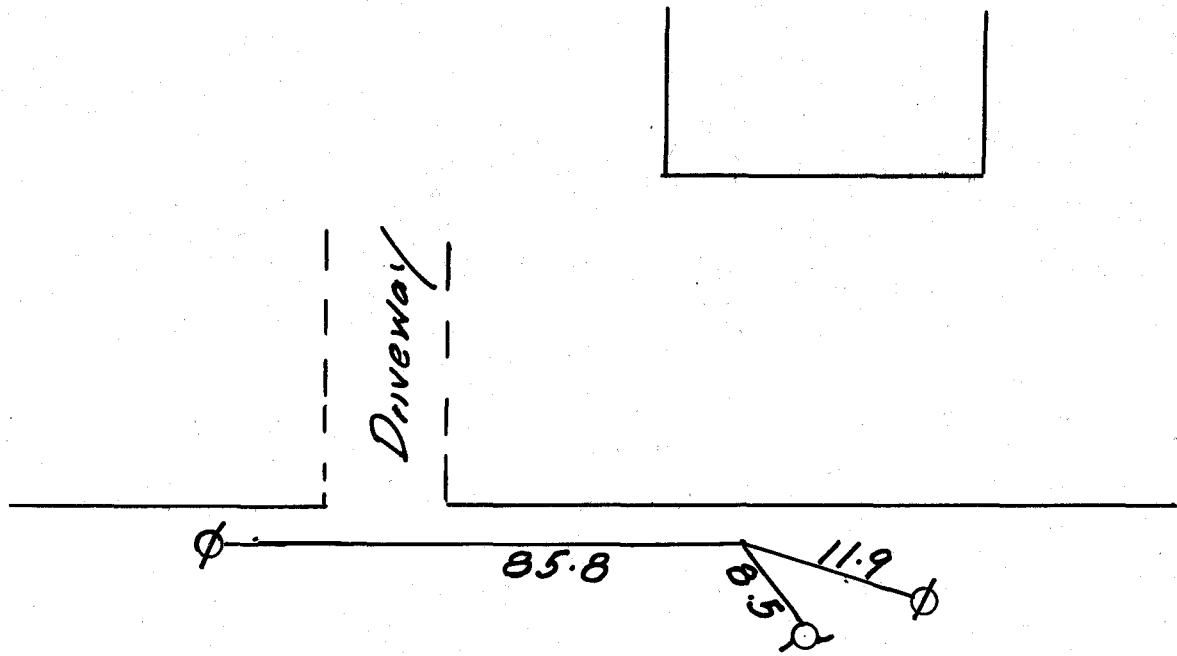

Name Allen Chamberlain

Service No. ~~905~~ 2600

Address ~~30 Pinckney St., Boston~~ Service to house on Summit Road

22 Summit Rd Location *22 Summit Rd.*

Kind of Pipe

Size

Size of Main

~~Repair~~ ~~Renewal~~ New Service

Location

Date

Material

Amount

Total

Date

Amount

73 *1 1/4"* C.L. Pipe @ .35 25 55

3 *1 1/4"* L.L. Couplings @ .40 1 20

1 *1 1/4" x 1"* L.L. " @ .40 40

1 1" Brass S. Nipple 30

Trucking 1 25 28 70

Total Labor 1 20

15% Overhead 18

30 08

Jan. 17 1927. Cash

30 08

Labor

11/15/26 2 Hrs. @ .60 1 20

The Bailey Press, Boston