

## WATER SERVICE RECORD

Name William Potter

Service No. 3

Address 25 Summit Road

# 1623

Location

~~Repair~~ - ~~Renewal~~ - ~~New Service~~ W.O. # 6293

AUG 5 1968


Date	Material	Amount	Total	Date	Amount
4/3/68	Labor	3 84		3-11-68	100 00
	10% O.H.	35	3 84	8-5-68	22 63
60'	1" copper @ .99		59 40		22 37
1"	3/4 stop and waster		11 13		
1	hr. trucking		3 00		
	TOTAL COST		77 37		

DATE \_\_\_\_\_

TOWN OF LEXINGTON — BOARD OF PUBLIC WORKS

WATER DIVISION

Sketch of Service Here

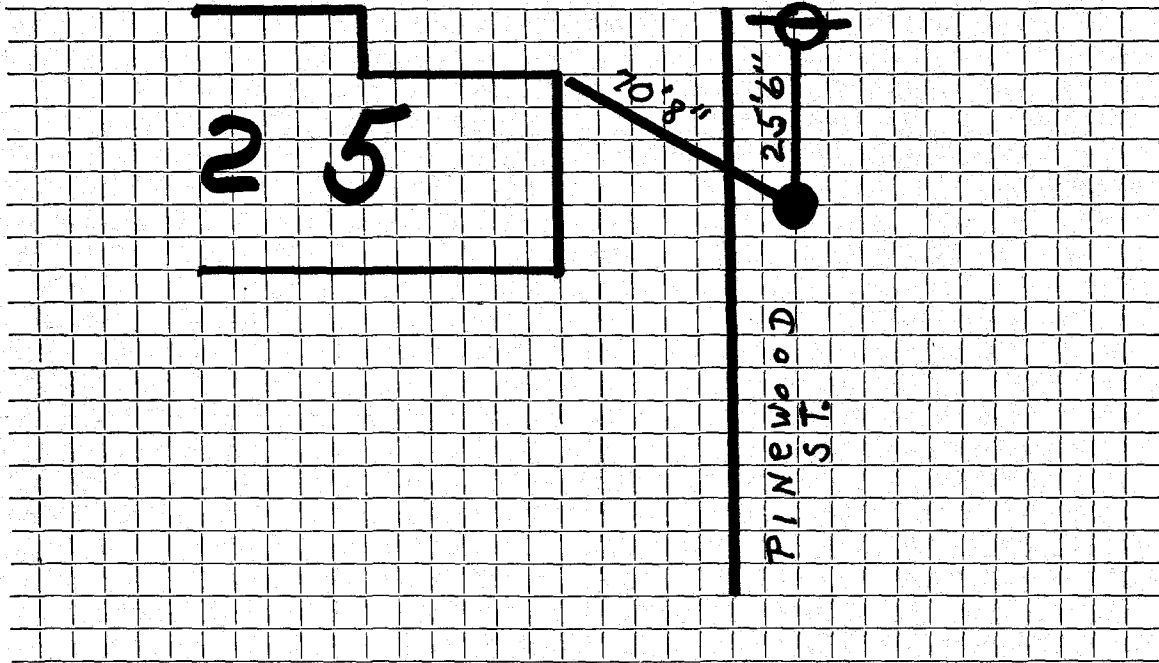

Connection made in ..... Street. Work completed .....

Remarks: *Original Service 6-10-33'* .....

.....  
.....