

Name C. Carroll Taylor

Service No. 297

Address 28 Summit Road
Lexington, Mass.

#7398

Location 28 Summit Road

Kind of Pipe

Size

Size of Main

~~XXXXXXXXXX~~ New Service

Com. 2-21-49

Location

Date	Material	Amount	Total	Date	Amount
Dec. 31, '48	Labor	1 15	1 15	Dec. 24 '48	60 00
	10% Overhead		12	Feb 28 '49	12 09
	130' - 3/4" Copper Tubing @.27	35 10			42 91
	1 - 3/4" C x 1/2" I.W.H. S&W	3 15		Dec. 31, '48	1 15
	2 - 3/4" C x 3/4" C Unions (3pts)	2 64		10' - 3/4" Copper Tubing @.27	2 70
	Trucking 1 hr. @.75	75		1 - 3/4" C Corp-cock	3 00
		42 91		1 - 3/4" C x 3/4" C Curb-cock	3 68
				1 - Box & Rod	3 55
				1 - 1/2" Straight Tail Piece	30
				1 - 1/2" Offset Tail Piece	30
				Trucking 1 hr, @.75	75
					15 43
	Labor				

TOWN OF LEXINGTON – BOARD OF PUBLIC WORKS

WATER DIVISION

The undersigned applies for a supply of water at No..... St. and hereby agrees to comply with the rules and regulations as now, or at any future time, established by the Board of Selectmen.

Am't of Estimate \$.....

Owner


Am't Paid \$.....

Address

Builder

.....

Sketch of Service Here

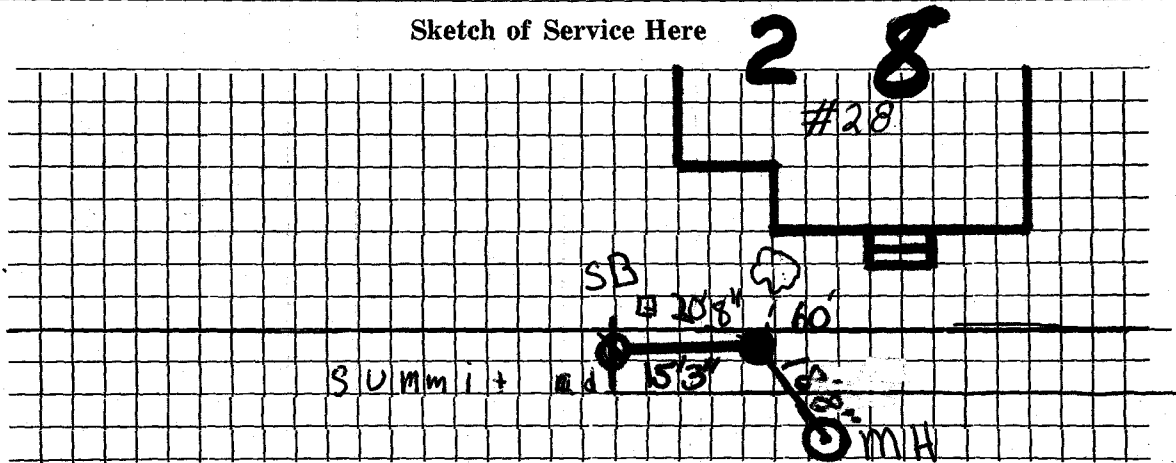

Connection made in Street.

Work completed19

Remarks: