


Date: 8/31/22

TOWN OF LEXINGTON - BOARD OF PUBLIC WORKS
WATER ~~SEWER~~ DIVISION

SKETCH OF SERVICE HERE

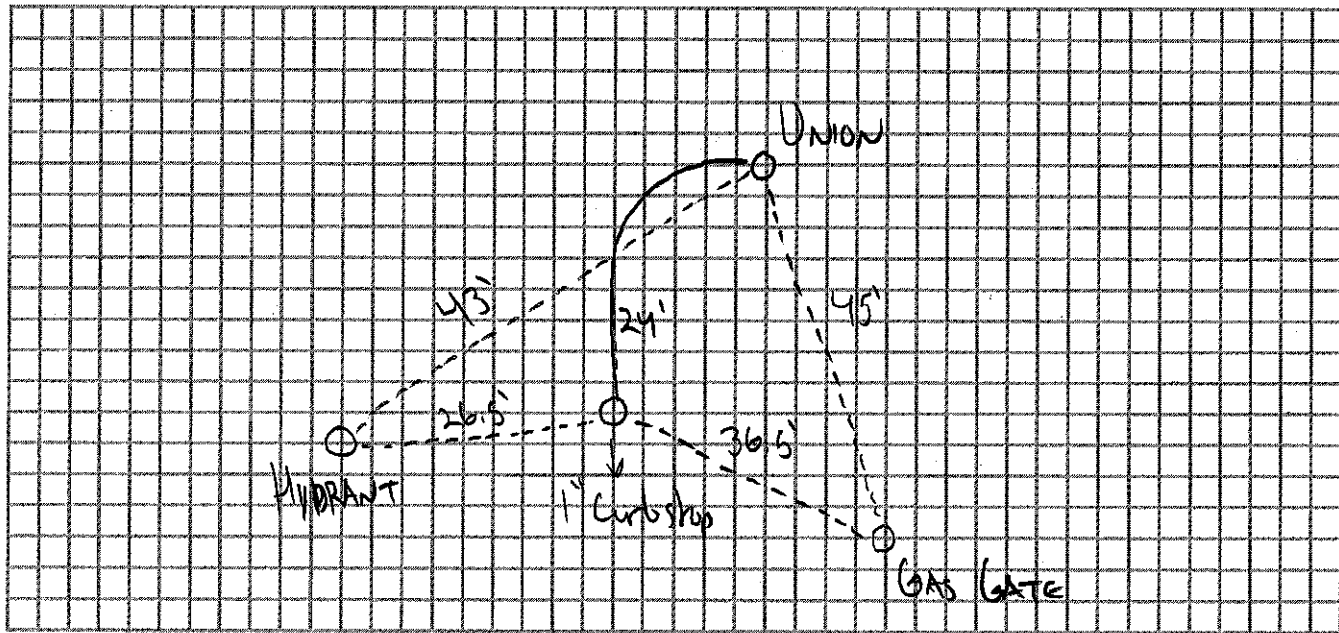

Connection made in: _____ Street. _____ Work completed: _____
Remarks: INSTALLED BY McLAUGHLIN