


DATE _____

TOWN OF LEXINGTON — BOARD OF PUBLIC WORKS

WATER DIVISION

Sketch of Service Here

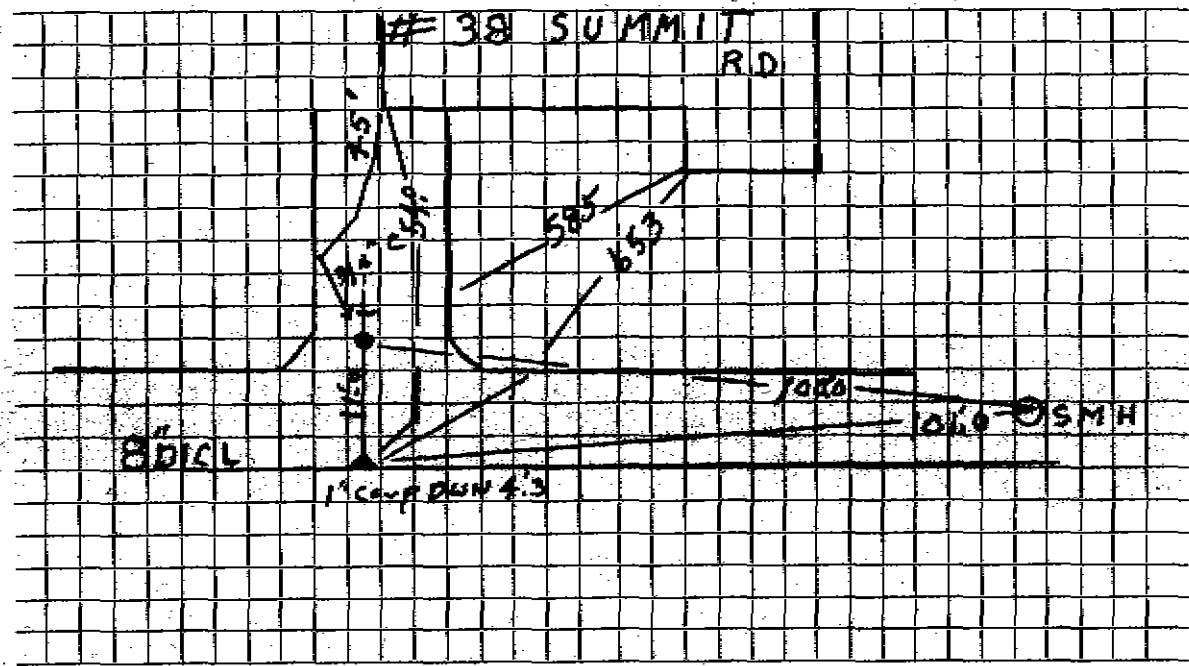

Connection made in Summit Rd Street.

Work completed 6/22/09 P.A.O.

Remarks:

.....

.....