


DATE 15 August 1996

TOWN OF LEXINGTON — BOARD OF PUBLIC WORKS

WATER DIVISION

Sketch of Service Here

4

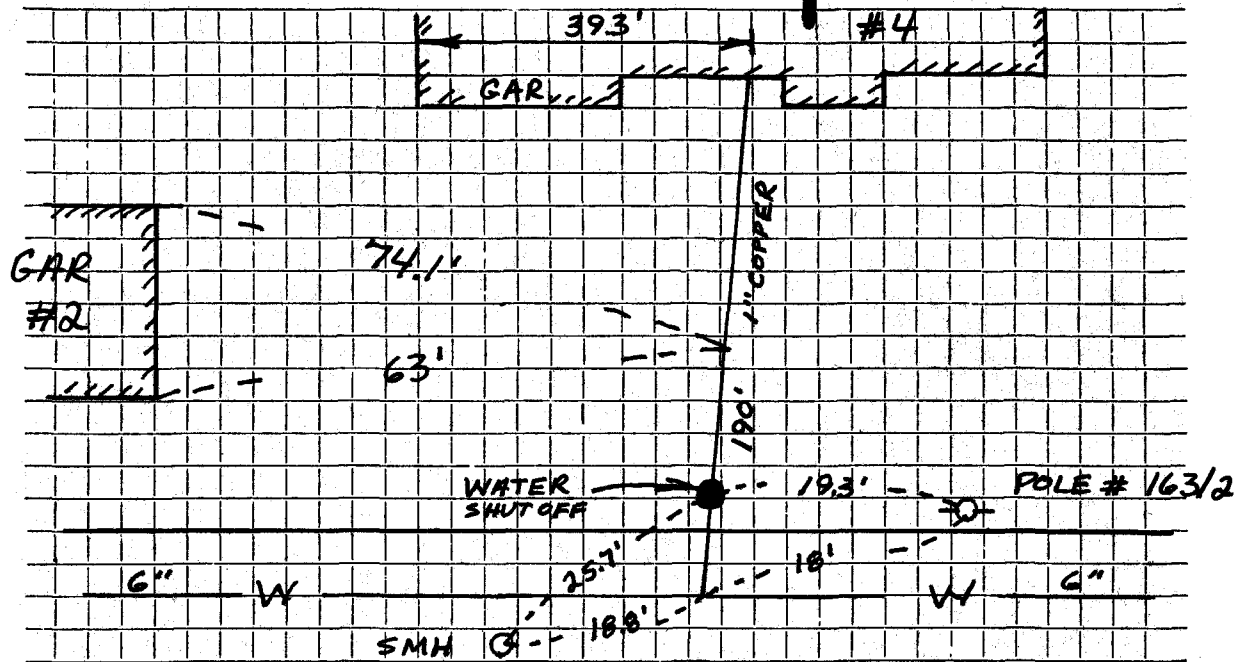

Connection made in SUMMIT ROAD Street. Work completed TOCCHI

Remarks: