


DATE _____

TOWN OF LEXINGTON — BOARD OF PUBLIC WORKS
WATER DIVISION

Sketch of Service Here

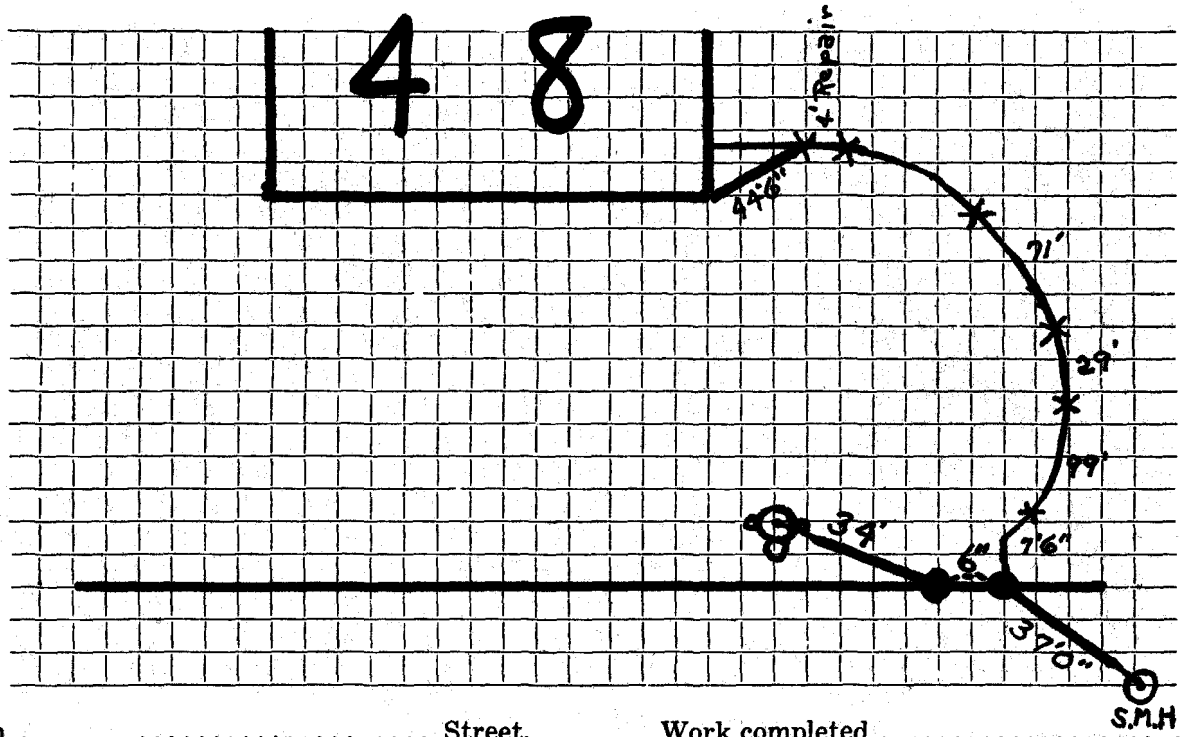

Connection made in Street. Work completed

Remarks: 2 Cur.b. Boxes 6" Apart - 1. Far. #47 Fern St. - 6" A.C. Sewer on Top of Water.