

Name Leeland Const. Co.

Service No.

27

Address 6 Summit Road

#4525

Lexington, Mass.

Location 6 Summit Road

Kind of Pipe

Size

Size of Main

~~REPAIR~~ ~~RENEW~~ New Service

Location

Date	Material	Amount	Total	Date	Amount
Nov. 26, '48	Labor	1 15	1 15	Nov. 12 '48	20 00
	10% Overhead		12	Dec. 31 '48	6 41
	33' - 3/4" Copper Tubing @.255	8 42	8 42		13 59
	1 - 3/4" x 1/2" I.W.H. S & W	3 15	3 15	Nov. 26, '48	1 15
	Trucking 1 hr. @ .75		75	5' - 3/4" Copper Tubing @.255	12 75
			13 59	1 - 3/4" Corp-cock	3 00
				1 - 3/4" C x 3/4" C Curb-cock	3 68
				1 - Box & Rod	3 55
				1 - 1/2" Offset Tail Piece	30
				1 - 1/2" Straight Tail Piece	30
				Trucking 1 hr. @.75	75
					25 48
	Labor				

TOWN OF LEXINGTON - BOARD OF PUBLIC WORKS

**WATER DIVISION**

The undersigned applies for a supply of water at No..... St. and hereby agrees to comply with the rules and regulations as now, or at any future time, established by the Board of Selectmen.

Am't of Estimate \$.....

Owner .....


Am't Paid \$.....

Address .....

Builder .....

.....

Sketch of Service Here

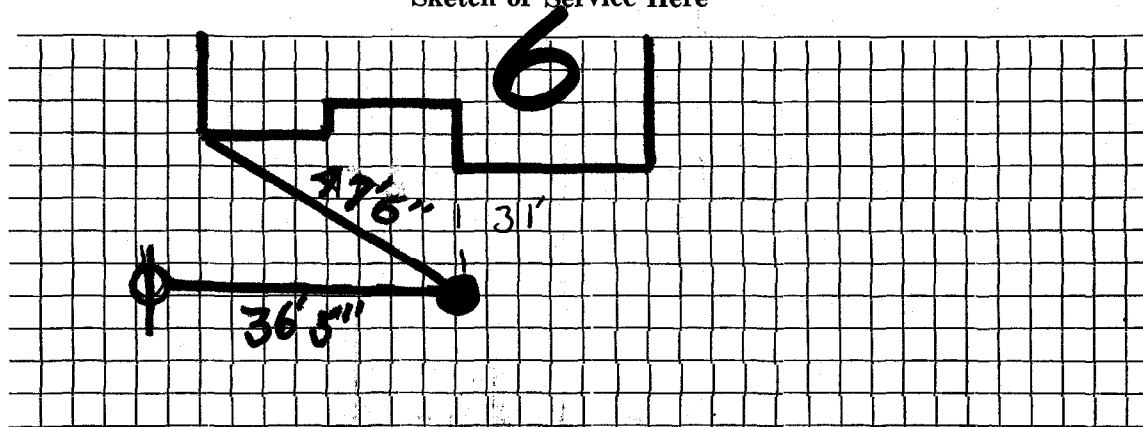

Connection made in ..... Street.

Work completed .....19

Remarks: