


DATE 6/26/92

TOWN OF LEXINGTON — BOARD OF PUBLIC WORKS

WATER DIVISION

Sketch of Service Here

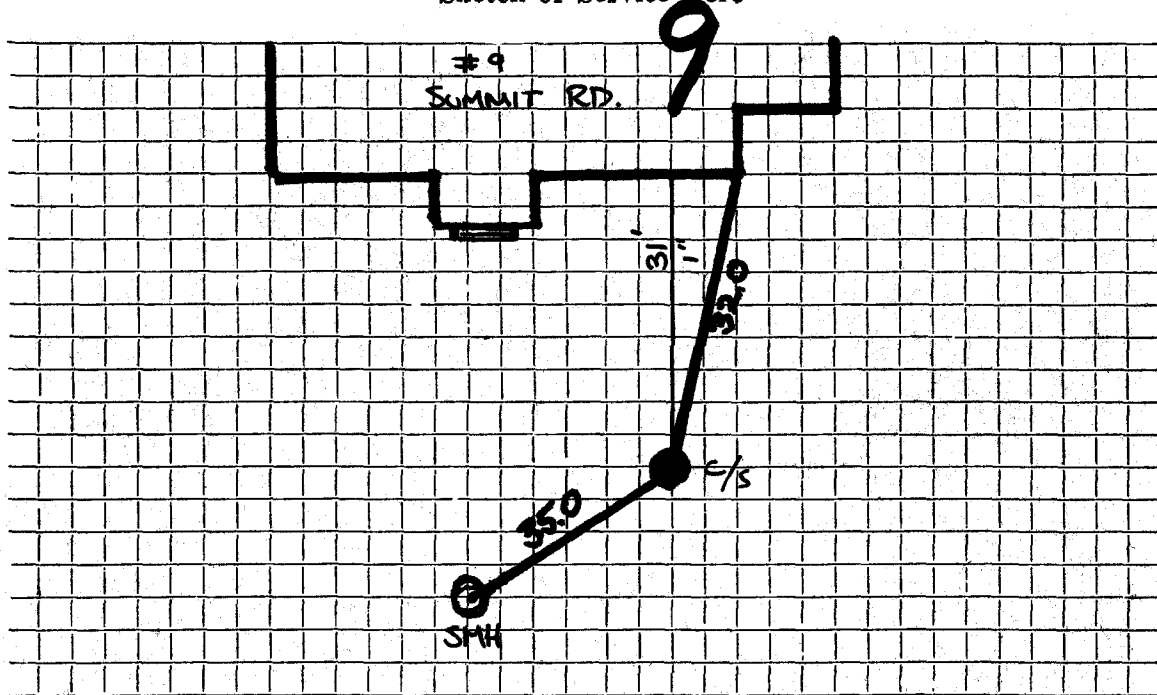

Connection made in Street. Work completed

Remarks: INSTALLED BY ARLEX Original Service 7-9-31
..... INSPECTED BY CRG