

## WATER SERVICE RECORD

Name Raymond Boudreau Service No. 229

Address 12 Sunny Knoll Terrace

Location

Repair—Renewal—New Service

Comm. 2/16/59


Date	Material	Amount	Total	Date	Amount
11/3/58	Labor	2 14		10/28/58	Deposit \$ 50 00
	10% overhead	21	2 35	2/16/59	Refund 25 89
	41' - 3/4" Copper tubing @ .37		15 17		\$ 24 11
	1 - 3/4" Cx 1/2" I.W.H. Stop & Waste		5 84		NON CHARGE
	1 hr. Trucking		75		
			24 11		
				Labor	5 37
				24' - 3/4" Copper tubing @ .37	8 88
				1 - 3/4" C. Corp Cock	4 64
				1 - 3/4" C. Curb Cock	6 03
				1 Box & rod	5 00
				1 - 1/2" Straight tailpiece	50
				1 - 1/2" Offset tailpiece	50
					30 92

DATE \_\_\_\_\_

TOWN OF LEXINGTON — BOARD OF PUBLIC WORKS

WATER DIVISION

Sketch of Service Here

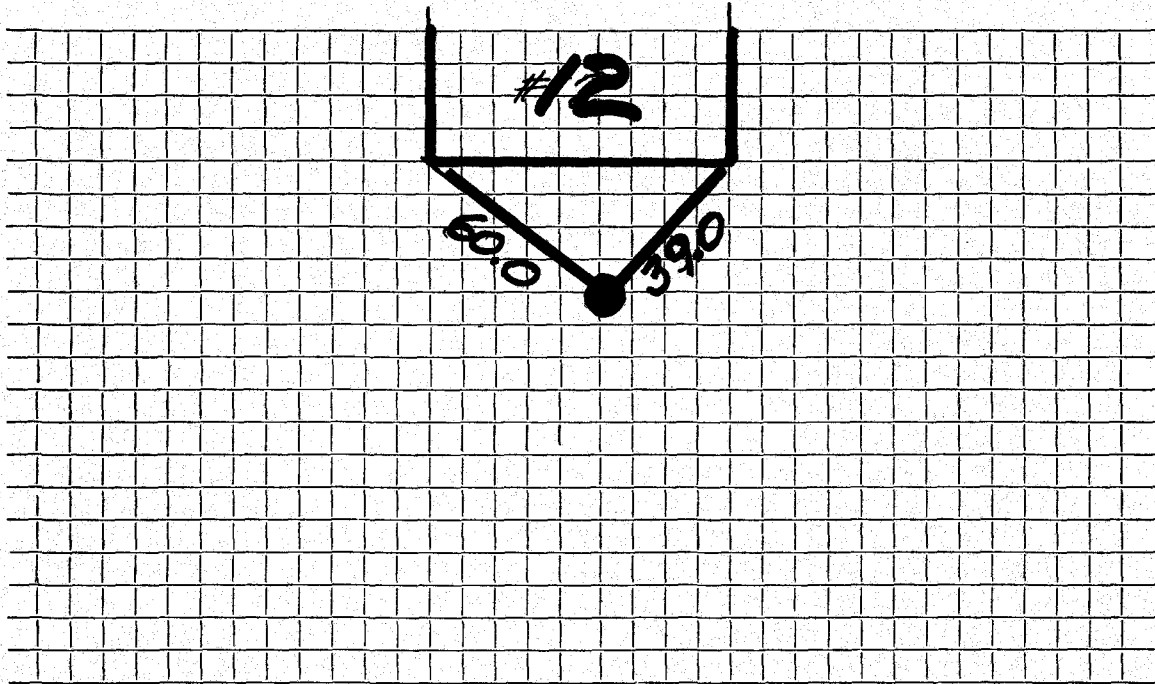

Connection made in ..... Street.      Work completed .....

Remarks: .....

.....

.....