

WATER SERVICE RECORD

1448

Name Raymond Boudreau

Service No. 230

Address 13 Sunny Knoll Terrace

Location

Repair—Renewal—New Service


Comm. 2/16/59

Date	Material	Amount	Total	Date	Amount
11/3/58	Labor	5 01		10/28/58	Deposit 50 00
	10% overhead	50	5 51	2/16/59	Refund 17 92
	54' - 3/4" Copper tubing @ .37		19 98		32 08
	1 - 3/4" Cx 1/2 I.W.H. Stop & Waste		5 84		NON CHARGE
	1 hr. Trucking @ .75		75	11/3/58	Labor 5 01
			32 08	5' - 3/4" Copper tubing @ .37	1 85
				1 - 3/4" C. Corp Cock	4 64
				1 - 3/4" C. Curb Cock	6 03
				1 Box & Rod	5 00
				1 - 1/2 Straight tailpiece	50
				1 - 1/2 Offset tailpiece	50
					23 53

DATE _____

TOWN OF LEXINGTON — BOARD OF PUBLIC WORKS
WATER DIVISION

Sketch of Service Here

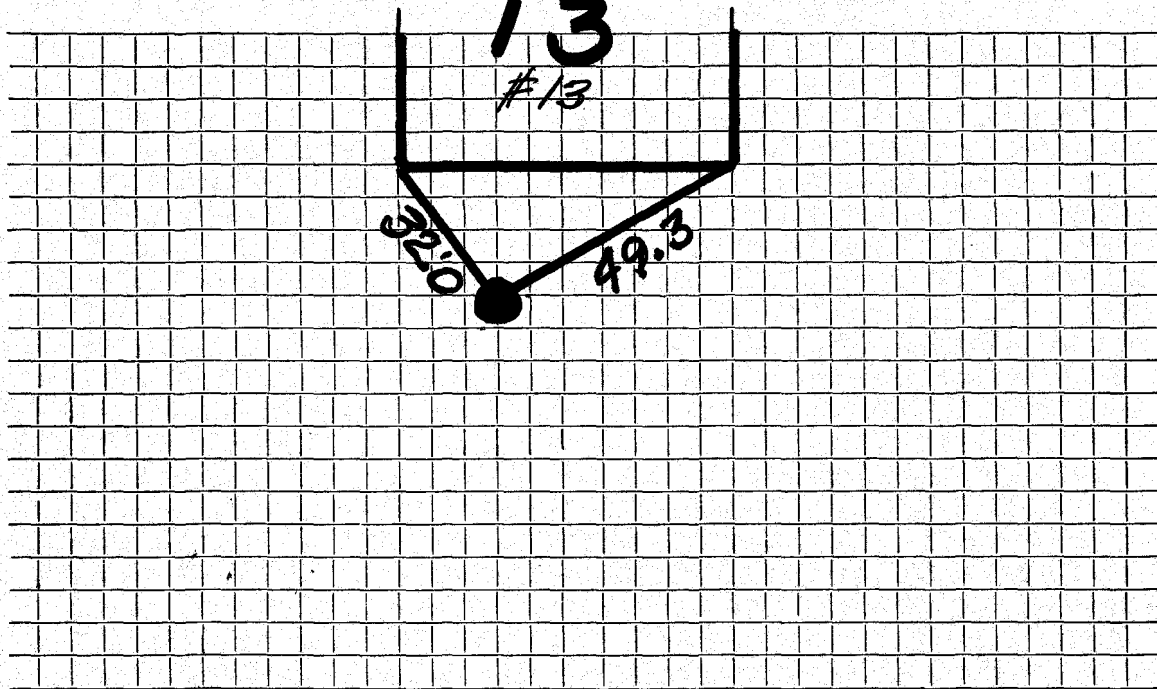

Connection made in Street. Work completed

Remarks:

.....

.....