

## WATER SERVICE RECORD

Name Raymond Boudreau

Service No. 231

Address 17 Sunny Knoll Terrace

Location

Repair—Renewal—New Service

Comm. 2/16/59


| Date    | Material                            | Amount | Total | Date                          | Amount           |
|---------|-------------------------------------|--------|-------|-------------------------------|------------------|
| 11/4/58 | Labor                               | 2 14   |       | 12/28/58                      | Deposit \$ 50 00 |
|         | 10% overhead                        | 21     | 2 35  | 2/16/59                       | Refund 23 67     |
|         | 47' - 3/4" Copper tubing @ .37      | 17 39  |       |                               | * 26 33          |
|         | 1 - 3/4" Cx 1/2 I.W.H. Stop & Waste | 5 84   |       |                               | NON CHARGE       |
|         | 1 hr. Trucking                      |        | 75    | Labor                         | 5 37             |
|         |                                     |        | 26 33 | 5' - 3/4" Copper tubing @ .37 | 1 85             |
|         |                                     |        |       | 1 - 3/4" C. Corp Cock         | 4 64             |
|         |                                     |        |       | 1 - 3/4" C. Curb Cock         | 6 03             |
|         |                                     |        |       | 1 Box & Rod                   | 5 00             |
|         |                                     |        |       | 1 - 1/2 Straight tailpiece    | 50               |
|         |                                     |        |       | 1 - 1/2 Offset tailpiece      | 50               |
|         |                                     |        |       |                               | 23 89            |

DATE \_\_\_\_\_

TOWN OF LEXINGTON — BOARD OF PUBLIC WORKS

WATER DIVISION

Sketch of Service Here

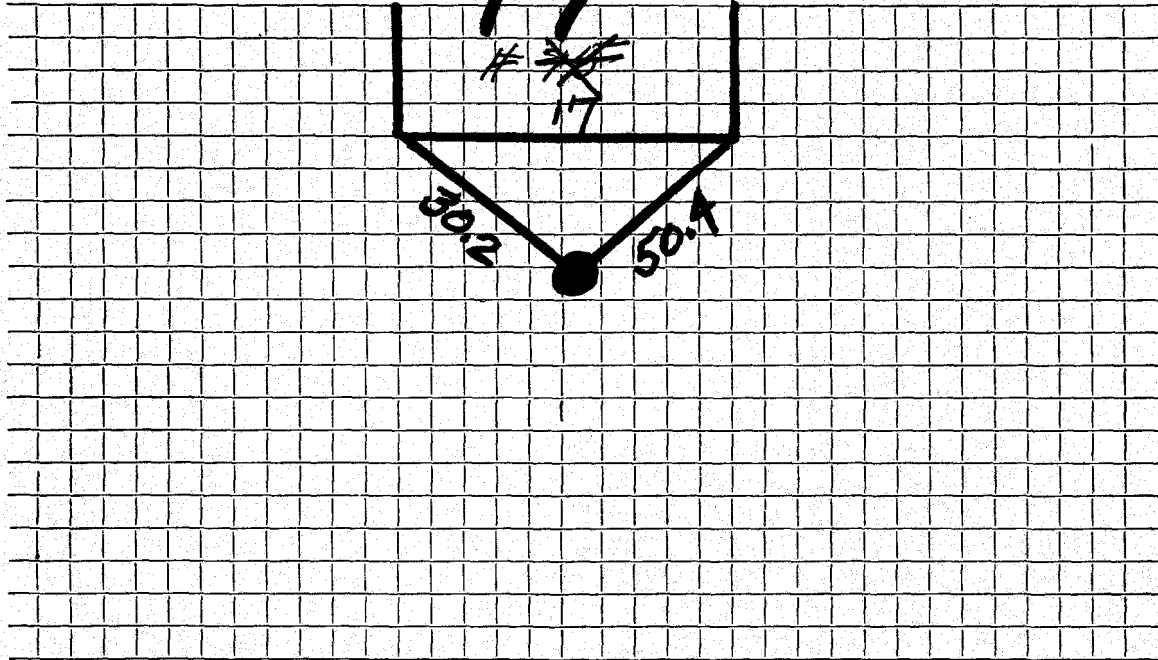

Connection made in ..... Street. Work completed .....

Remarks: .....

.....

.....