

WATER SERVICE RECORD

Name Abbie W. Fuller

Service No. 13

Address 1 Sunnyknoll Avenue

2081

Location

~~Repair~~ ~~Renewal~~ ~~NEW SERVICE~~ W.O. # 7631

JUL 27 1970


Date	Material	Amount	Total	Date	Amount	
5/18/70	Labor	44 61		4-27-70	Deposit	245 00
	10% O.H.	4 46	49 07	7-29-70	Retain	179 46
73'	3/4" Copper pipe .79		57 67			125 54
1	3/4" Wheel Valve		9 30			
1	Hr. Truckinf		3 00		<u>OUTSIDE</u>	
1	Hr. Shovel		6 50	5/18/70	Labor	29 74
			125 54	5'	3/4" Copper pipe .79	3 95
				1	3/4" Curb cock	11 32
				1	3/4" Adapter	2 76
				1	Hr. trucking	3 00
				1	Hr. Shovel	4 00
						54 77

DATE _____

TOWN OF LEXINGTON — BOARD OF PUBLIC WORKS

WATER DIVISION

Sketch of Service Here

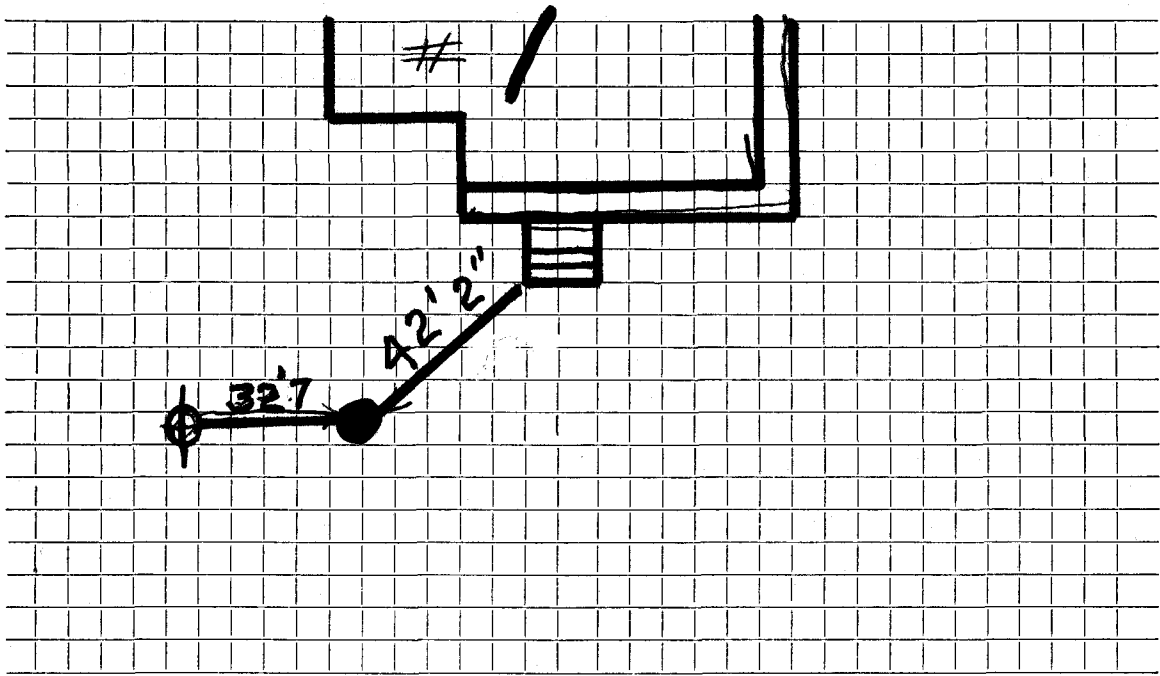

Connection made in Street. Work completed

Remarks:
.....
.....