

Name Daniel A. Gorman

Service No. ~~2607~~ 2607

Address ~~45 Reed Street~~

11 Sunnyknoll Ave

7068

Location 11 Sunnyknoll Avenue

Kind of Pipe

Size

Size of Main

Repair—Renewal—New Service

Location

Date 1938	Material	Amount	Total	Date	Location	Amount
June 20	2 hrs. @ 60	1 20	1 20	June 20, 1938	Deposited	17 50
<i>Jan 7-5-38</i>	38' 3/4" C. Tubing @ 20¢		7 60			
	1 3/4" Bushing		30			
	1 S. & W.		3 75			
	2 hrs. Trucking @ 75¢		1 50			
			<u>14 35</u>			
	Flat Rate:	\$17.50				
	Labor					

Hadley Press, Inc., Lexington

DATE _____

TOWN OF LEXINGTON—BOARD OF PUBLIC WORKS

WATER DIVISION

The undersigned applies for a supply of water at No. _____ St. and hereby agrees to comply with the rules and regulations as now, or at any future time, established by the Board of Selectmen.

Am't. of Estimate \$ _____


Owner _____

Am't. Paid \$ _____

Address _____

Builder _____

Sketch of Service Here

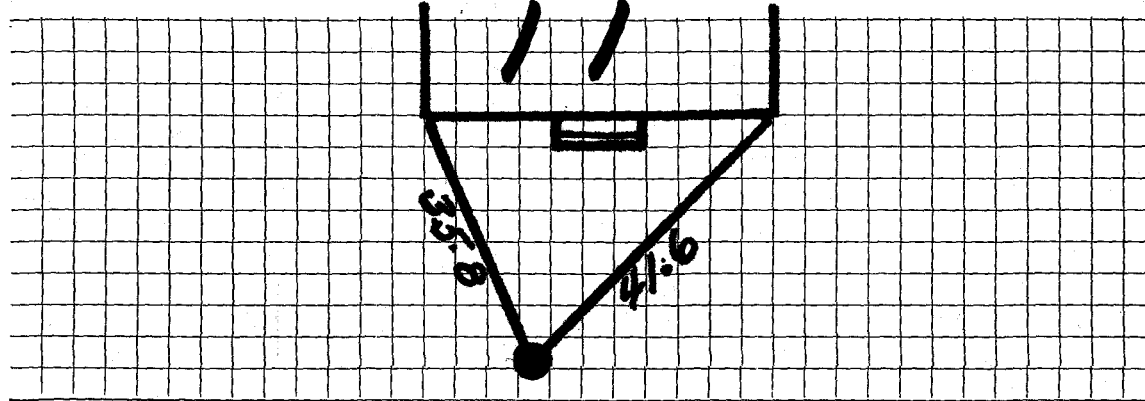

Connection made in _____ Street.

Work completed _____ 19

Remarks: