

WATER SERVICE RECORD

Name

Service No.

Address 3 Sunnyknoll Ave

Location

Repair—Renewal—New Service


Date	Material	Amount	Total	Date	Amount
	Inside 1" Copper				
				10-26-90	Outside:
					9'-1" Copper
					1-1" Comp Curb
					1- 5/8 x 3/4 Corp Adp
					1- 1" x 3/4 Adp
					1- Box + Rod

DATE \_\_\_\_\_

TOWN OF LEXINGTON — BOARD OF PUBLIC WORKS

**WATER DIVISION**

Sketch of Service Here

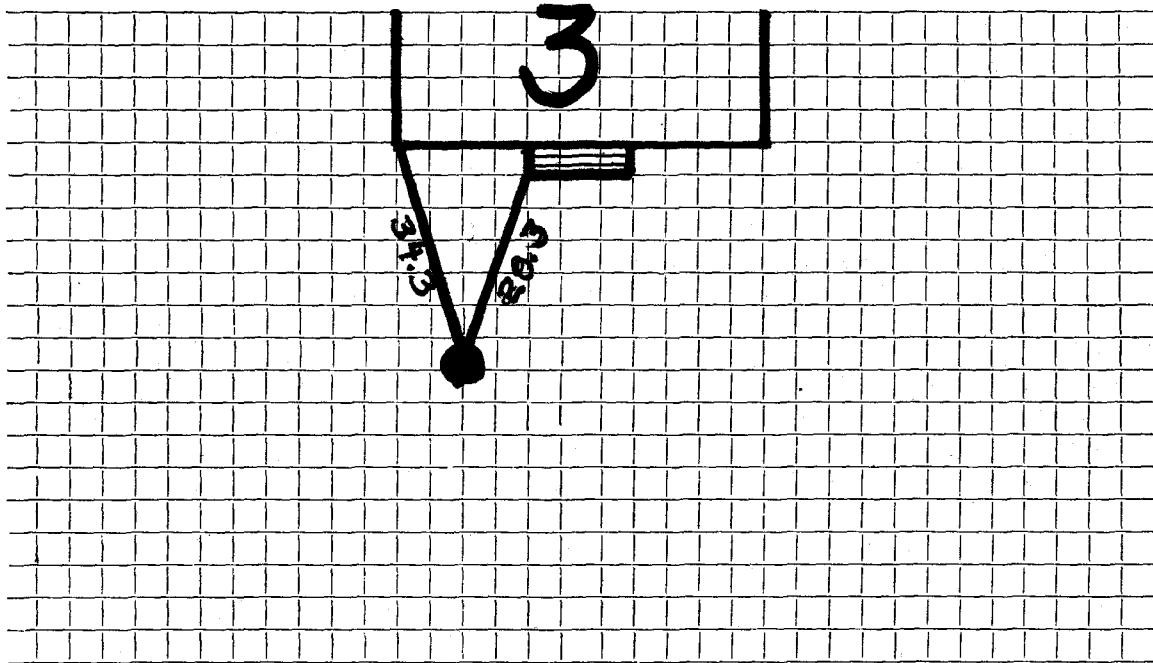

Connection made in ..... Street.      Work completed .....

Remarks: .....  
.....  
.....