

WATER SERVICE RECORD

Name Mr. J. Orsillo

Service No. 69

Address 5 Sunnyknoll Avenue

Location

~~Repair - Renewal - New Service~~ W.O. #5560

AUG 5 1968


Date	Material	Amount	Total	Date	Amount
10/10/67	Labor	26 73			
	10% O.H.	2 67=	29 40	9-29-68	Deposit 125 00
	40' 3/4" copper tubing @.79		31 60	8-3-68	Returned 45 30
	1 3/4" Wheel valve		9 30		79 80
	1 Hr. Trucking		3 00		
	1 Hr. Shovel		6 50		
			79 80		
	CURB TO MAIN				
10/10/67	Labor		17 82		
	7' 3/4" copper tubing		5 53		
	1 3/4" Curb cock		11 32		
	1 3/4" Corp.		7 42		
	1/2 Yard Loam		1 75		
	1/2 Lb. grass seed		55		
	1 Hr. Trucking		3 00		
	2 Hrs. shovel @ 6.50		13 00		
			60 39		

DATE _____

TOWN OF LEXINGTON — BOARD OF PUBLIC WORKS

WATER DIVISION

Sketch of Service Here

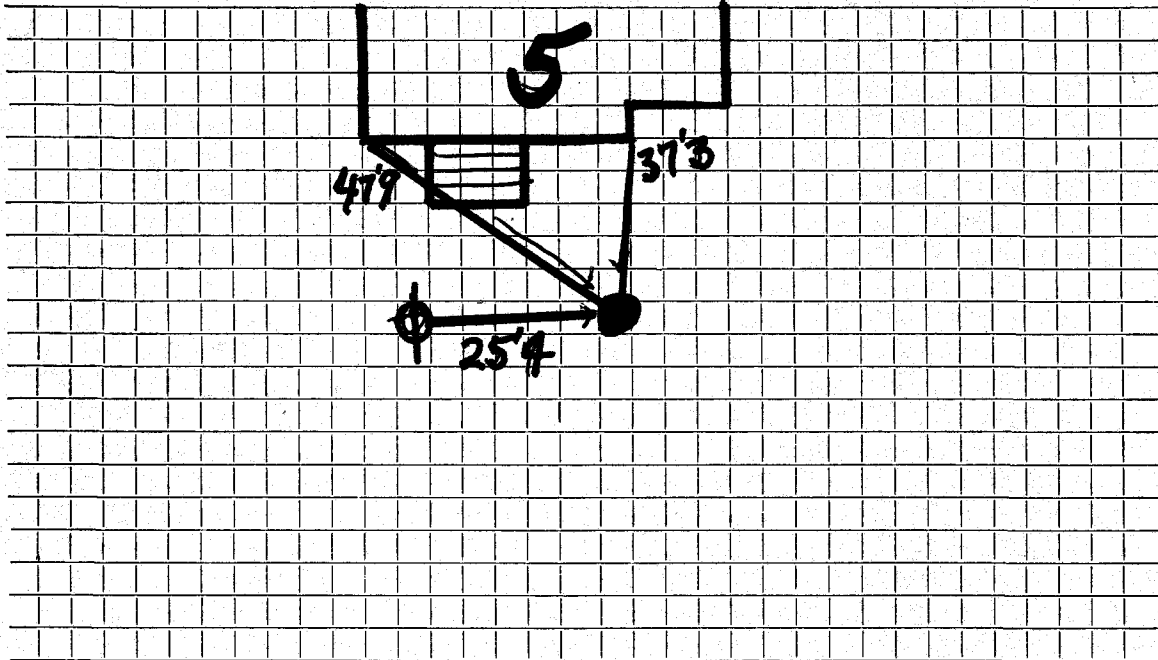

Connection made in Street. Work completed

Remarks:

.....

.....