


DATE _____

TOWN OF LEXINGTON — BOARD OF PUBLIC WORKS

WATER DIVISION

Sketch of Service Here

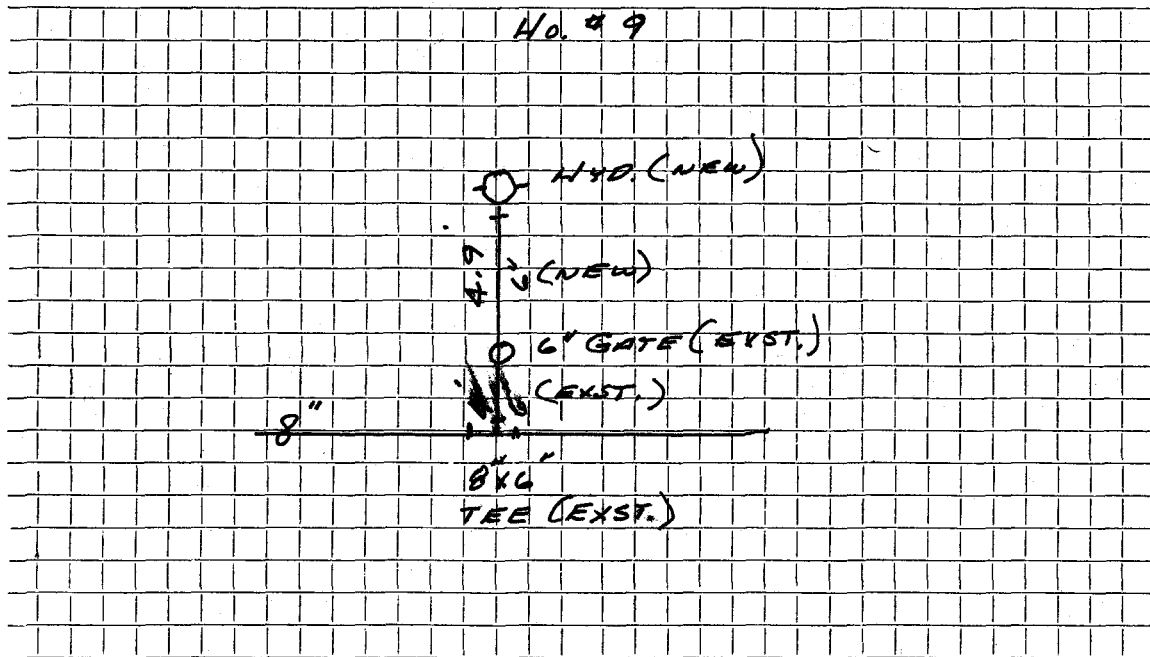

Connection made in SUNNYKNOLL Street. Work completed

Remarks: NEW HYD. & 4'-6" CI.

JT & C - CONTRACTOR