

WATER SERVICE RECORD

#6617

Service No. 238 (1956)

Name Raymond F. Boudreau

Address 10 Sunny Knoll Terrace

Location

~~Repair - Renewal~~ - New Service

Comm. 2-25-57


#7505

Date	Material	Amount	Total	Date	Amount
8/17/56	Labor	11 50		8-10-56	Deposit \$ 100 00
	10% overhead	1 15	12 65	7/25/57	Refund 17 39
	50' - 3/4" Copper tubing @ .4850	24 25			NON CHARGE \$ 82 61
	1 - 3/4" Cx 1/2 I.W.H. Stop & Waste	4 96		Labor	7 57
	1 hr. Trucking		75	32' - 3/4" Copper tubing @ .4850	15 52
	2 hrs. Littlefield Shovel @ 8.50	17 00		1 - 3/4" C. Corp Cock	4 64
	23x3 Patch		23 00	1 - 3/4" C. Curb Cock	5 94
			82 61	1 Box & Rod	4 62
				1 - 1/2 Straight tailpiece	50
				1 - 1/2 Offset tailpiece	50
				1 2/3 hrs. Littlefield Shovel @ 8.50	14 16
					53 45

TOWN OF LEXINGTON — BOARD OF PUBLIC WORKS

WATER DIVISION

Sketch of Service Here

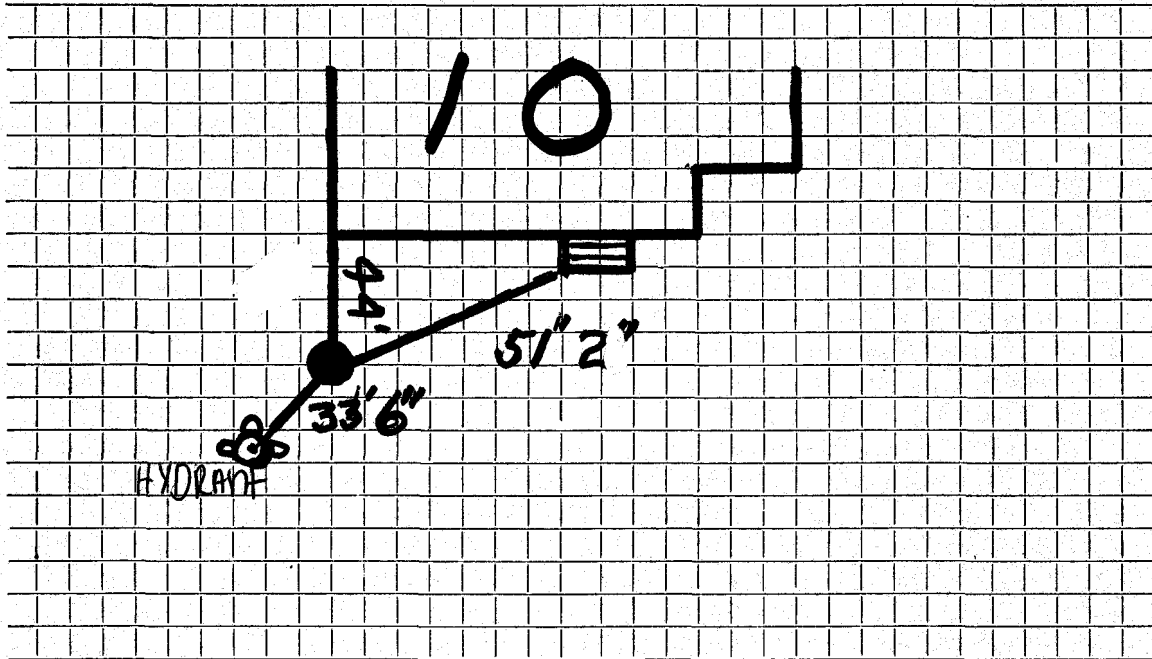

Connection made in Street. Work completed

Remarks:

.....

.....