

WATER SERVICE RECORD

Name Raymond Boudreau

Service No. 228

Address 11 Sunny Knoll Terrace

Location

~~Repair—Renewal—New Service~~

Comm. 2/16/59


Date	Material	Amount	Total	Date	Amount
11/3/58	Labor	2 85		10/28/58	Deposit 50 00
	10% overhead	29	3 14	2/16/59	Refund 19 18
	57' - 3/4" Copper tubing @ .37		21 09		\$ 30 82
	1 - 3/4" Cx $\frac{1}{2}$ I.W.H. Stop & Waste		5 84		NON CHARGE
	1 hr. Trucking		75		Labor 7 17
			30 82		5' - 3/4" Copper tubing @ .37 1 85
					1 - 3/4" C. Corp Cock 4 64
					1 - 3/4" C. Curb Cock 6 03
					1 Box & Rod 5 00
					1 - $\frac{1}{2}$ Straight tailpiece 50
					1 - $\frac{1}{2}$ Offset tailpiece 50
					25 69

DATE _____

TOWN OF LEXINGTON — BOARD OF PUBLIC WORKS

WATER DIVISION

Sketch of Service Here

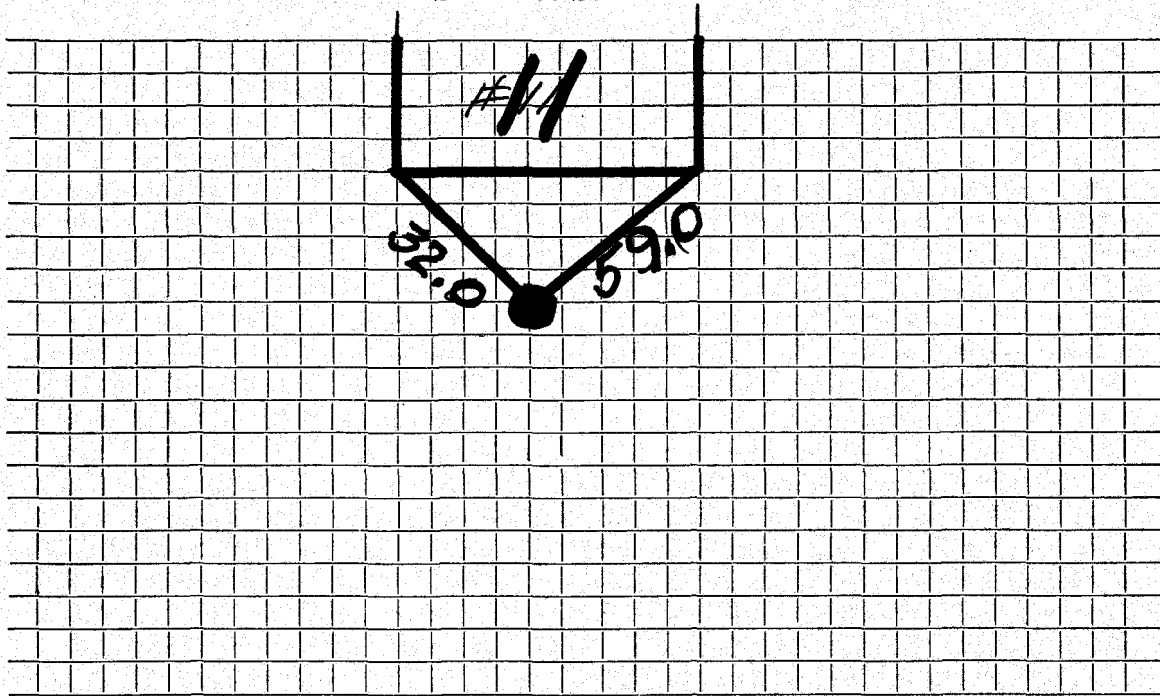

Connection made in Street. Work completed

Remarks:

.....

.....