

WATER SERVICE RECORD

Name S & A Realty (Ralph Hall)

Service No. 23

Address 18 Sunnyknoll TER.

Location

~~Repair or Renewal~~—New Service W.O.#987 DeFlice Bros. #2296

APR 8 1974


Date		Material	Amount	Total	Date	Amount
7-19-73	42'	3/4" Copper			7-16-73	100.00
					4-8-74	48.14
11-4-58		Labor	14.94			51.84
		10% O.H.	1.49	\$ 16.43		
	27'	3/4" Copper @ .37/Ft.		9.99		
	1	3/4" Corp. Cock		4.64		
	1	3/4" Curb Cock		6.03		
	1	Box & rod		5.00		
	2	hrs. Backhoe @ 4.50		9.00		
	1	hr. Trucking @ .75		.75		
				\$ 51.84		

DATE _____

TOWN OF LEXINGTON — BOARD OF PUBLIC WORKS

WATER DIVISION

Sketch of Service Here

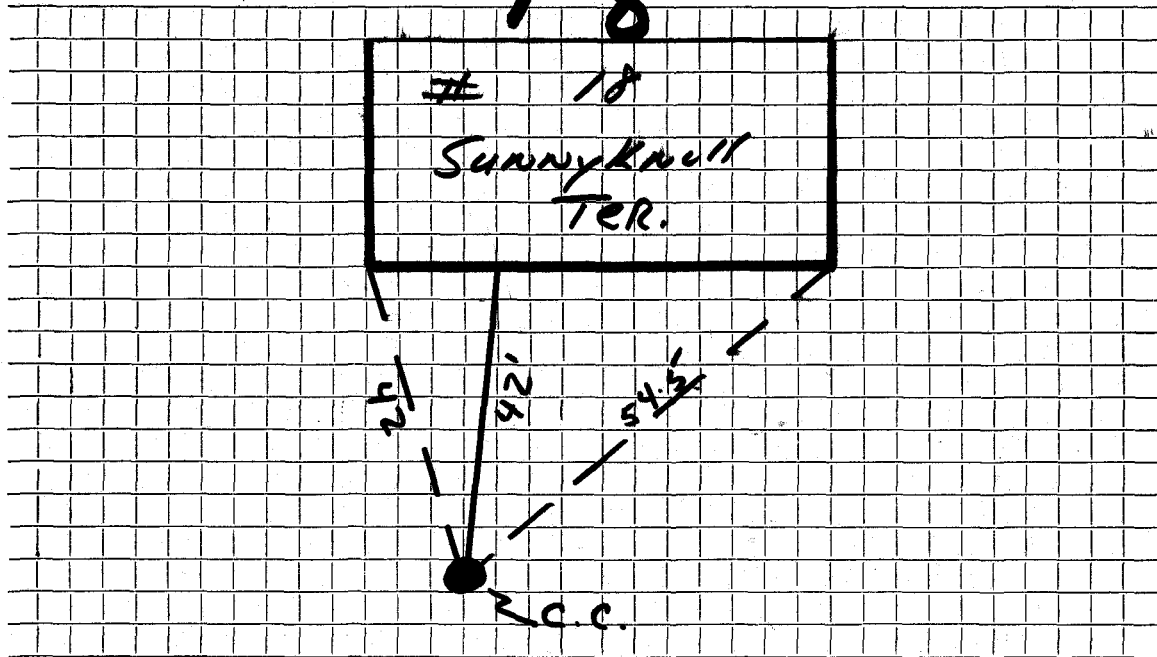

Connection made in Street. Work completed

Remarks:
.....
.....