

WATER SERVICE RECORD

#4001

#6050

Name George R. Fuller

Service No. 149

Address 3 Sunny Knoll Terrace

Location

Repair—Renewal—New Service

Comm. 9/30/57


Date	Material	Amount	Total	Date	Amount	
7/25/57	Labor	1 94		7-23-57	Deposit	\$ 50 00
	10% overhead	19	2 13	9-30-57	Refund	31 66
	30' - 3/4" Copper tubing @ .375		11 25		NON CHARGE	# 18 34
	1 - 3/4" Cx 1/2 I.W.H. Stop & Waste		4 96		Labor	7 74
			18 34		12' - 3/4" Copper tubing @ .375	4 50
					1 - 3/4" Corp Cock	4 64
					1 - 3/4" Curb Cock	5 94
					1 Box & Rod	4 62
					1 - 1/2 Straight tailpiece	50
					2 - 1/2 Offset tailpiece	50
					1 hr. Town Shovel	6 50
						34.94

DATE _____

TOWN OF LEXINGTON — BOARD OF PUBLIC WORKS

WATER DIVISION

Sketch of Service Here

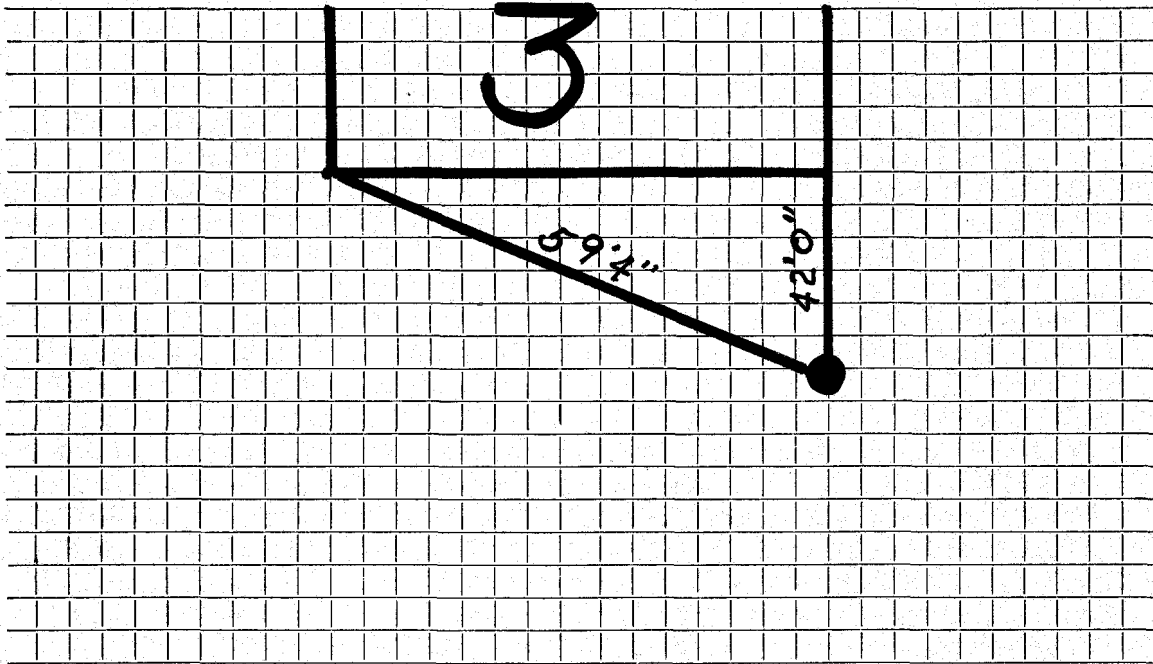

Connection made in Street. Work completed

Remarks:
.....
.....