


**Water Service Tie Card**  
**TOWN OF LEXINGTON**  
 MASSACHUSETTS

**5 Sunny Knoll Terr**

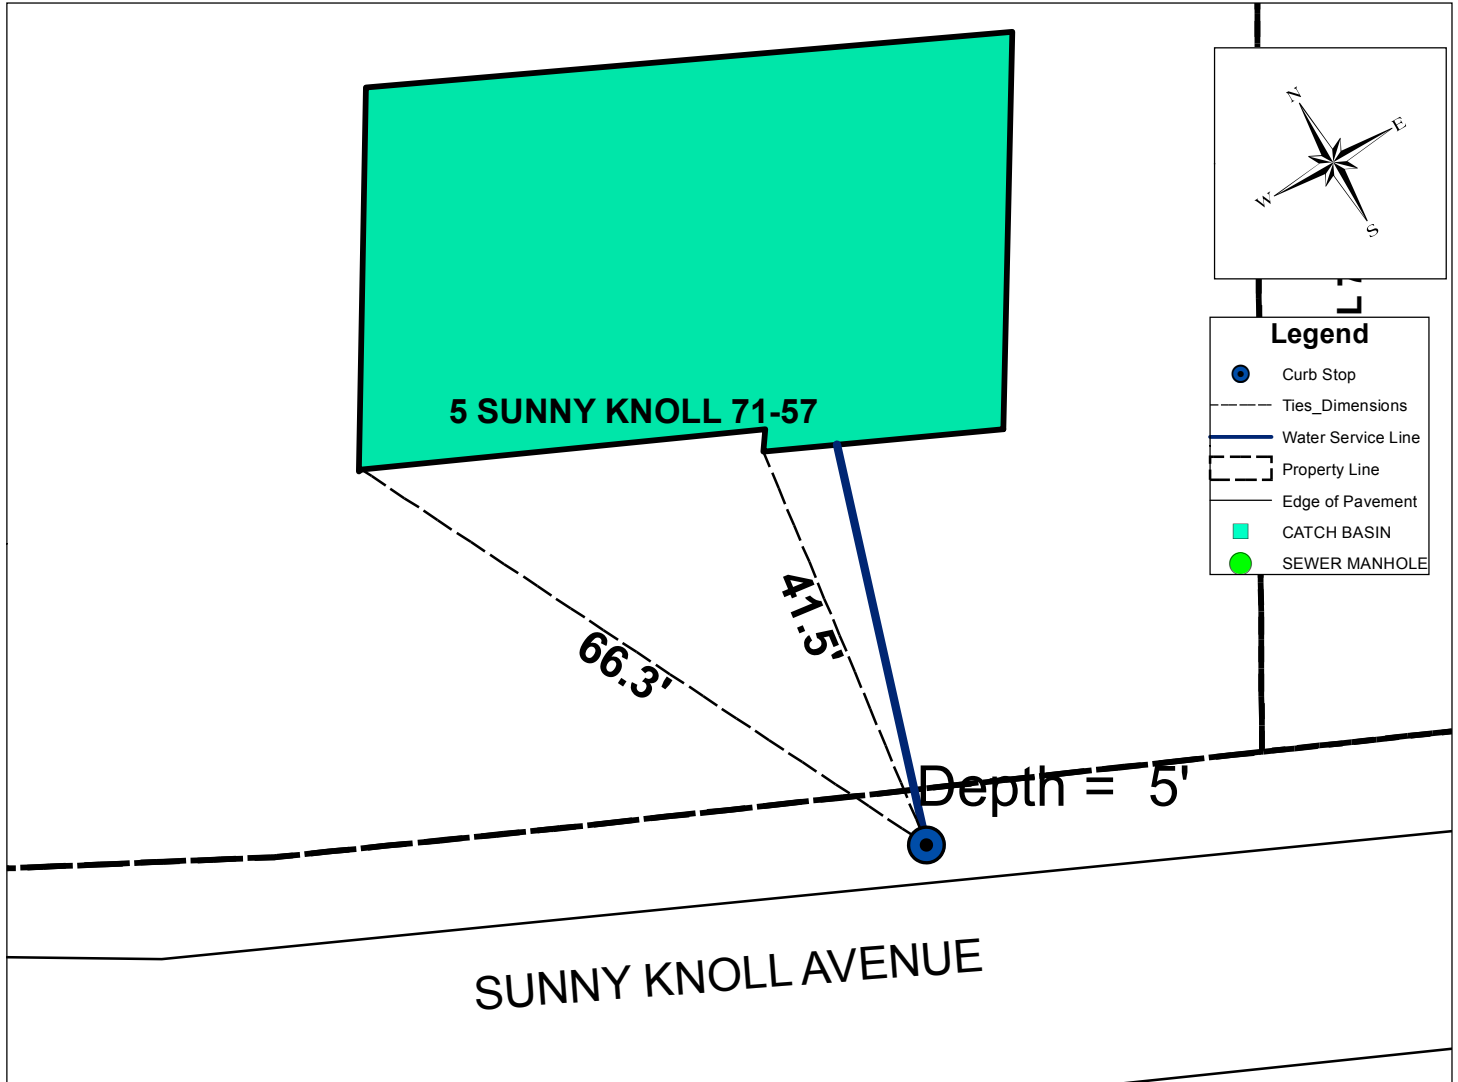

Address	Map and Lot	Permit Number	Contractor Name	Inspector
5 Sunnyknoll Terr	71-57	5884	McLaughlin, James M. Inc.	dpavlik
Date	Material	Depth of Cover	Amount	
10/30/2014	3/4" Copper type "k"	5 ft	6"	
	3/4" to 1" fitting	5 ft	1	
	1" Curb Valve and Buffalo Box	5 ft	1	
	1" Copper type "k"	5 ft	44.6 ft to HSE	
<b>Type of work completed</b>				

New 1" water service to house from curb stop. New house on lot old house removed.