

WATER SERVICE RECORD

Name Raymond F. Boudreau

Service No. 187

Address 8 Sunny Knoll Terrace

Location

~~Repair~~ ~~Renewal~~—New Service

Comm. 10-8-56


Date	Material	Amount	Total	Date	Amount	
7/12/56	Labor	10 65		7-10-56	Deposit	75 00
	10% Overhead	1 07	11 72	10 8 56	Returned NON CHARGE	14 61
	36 3/4 Copper tubing @.4850		17 46		1 1/2 Straight tail piece	50
	1 3/4" Cx 1/2 I.W.H. Stop & Waste		4 96		1 1/2 Offset " "	50
	1 hr. trucking		75			100
	3 hrs. Littlefield @8.50		25 50			
			60 39			

DATE _____

TOWN OF LEXINGTON — BOARD OF PUBLIC WORKS

WATER DIVISION

Sketch of Service Here

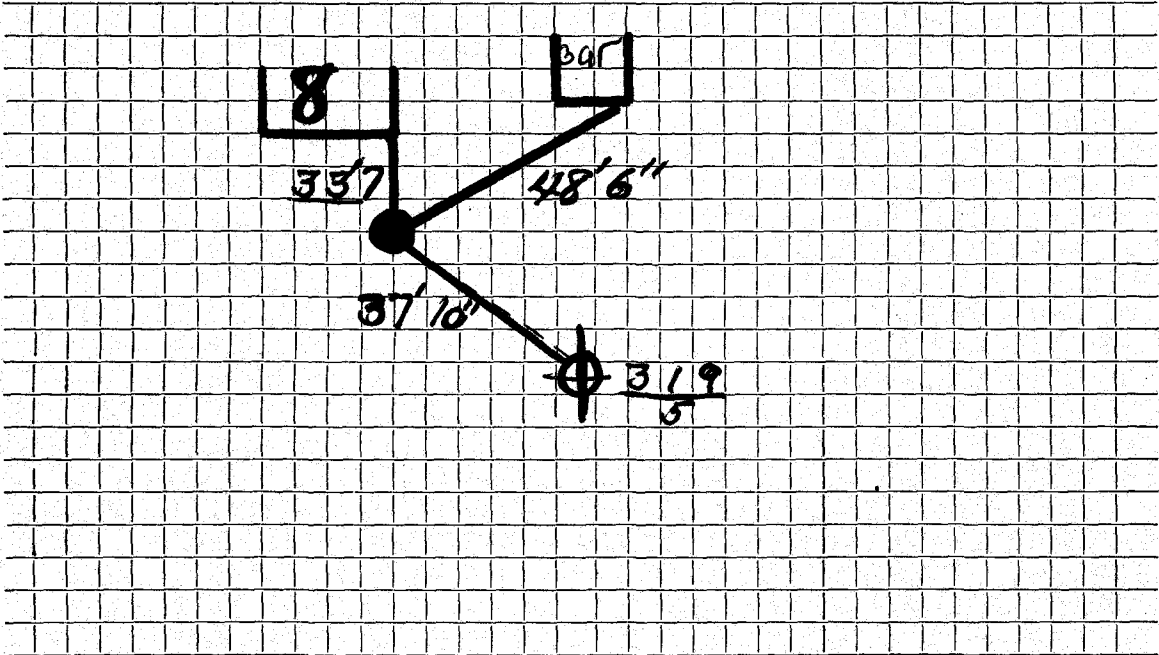

Connection made in Street. Work completed

Remarks:
.....
.....