

WATER SERVICE RECORD

Name *Richard Galehouse*

Service No.

Address *3 Sunset Ridge*

Location

Repair—Renewal—(New Service) *R.J. Cincotta #4604*


Date	Material	Amount	Total	Date	Amount
<i>10/11/86</i>	<i>22 LF 1" COPPER</i>				
	<i>1" CORP.</i>				
	<i>1" CORP w/Box</i>			<i>10-11-86</i>	
	<i>102 LF 1" COPPER</i>			<i>22' 1" Copper</i>	
				<i>1 1" C. Corp Cock.</i>	
				<i>1 1" C. Curb Cock</i>	
				<i>1 Box</i>	

DATE _____

TOWN OF LEXINGTON — BOARD OF PUBLIC WORKS

WATER DIVISION

Sketch of Service Here

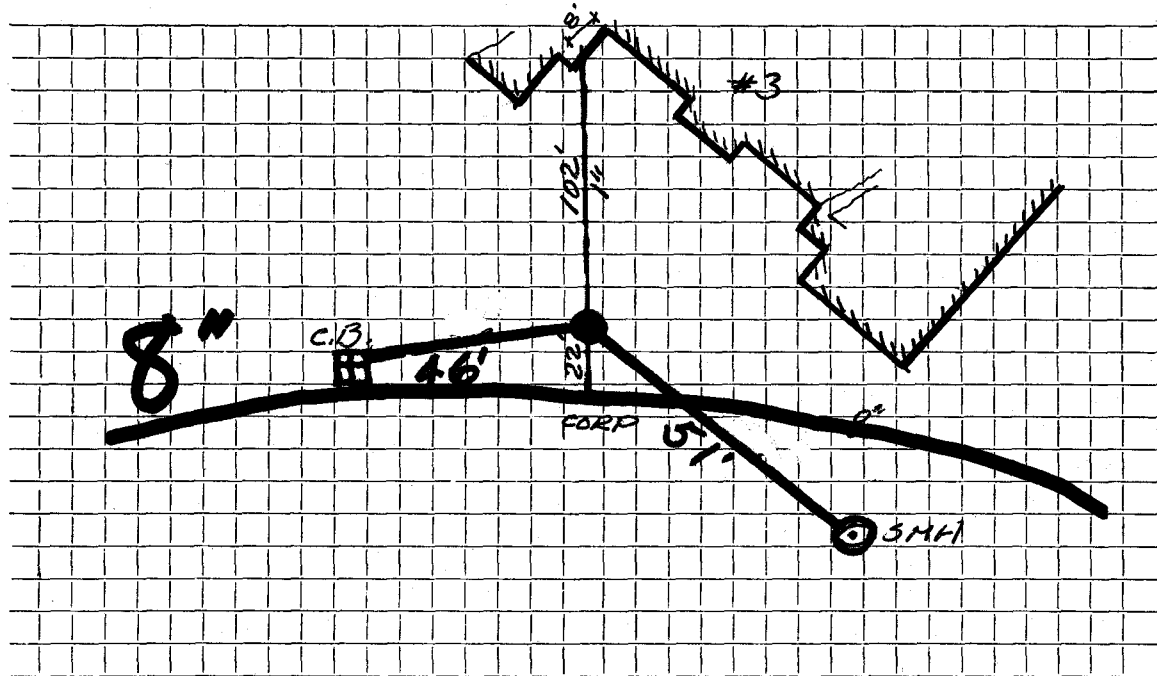

Connection made in SUNSET Ridge Street. Work completed

Remarks:
.....
.....