


DATE _____

TOWN OF LEXINGTON — BOARD OF PUBLIC WORKS
WATER DIVISION

Sketch of Service Here

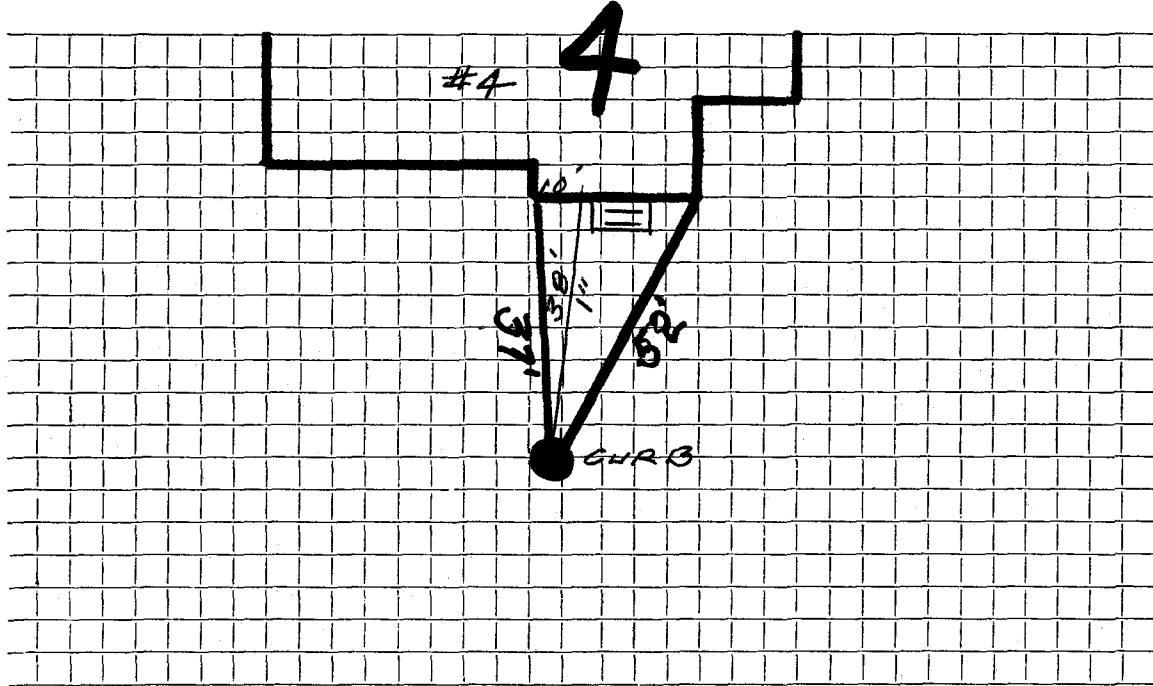

Connection made in SUNSET RIDGE Street. Work completed

Remarks: NO OUTSIDE TIES

Subd. 1.015.10.4