


DATE AUGUST 14, 1997

TOWN OF LEXINGTON — BOARD OF PUBLIC WORKS

WATER DIVISION

Sketch of Service Here

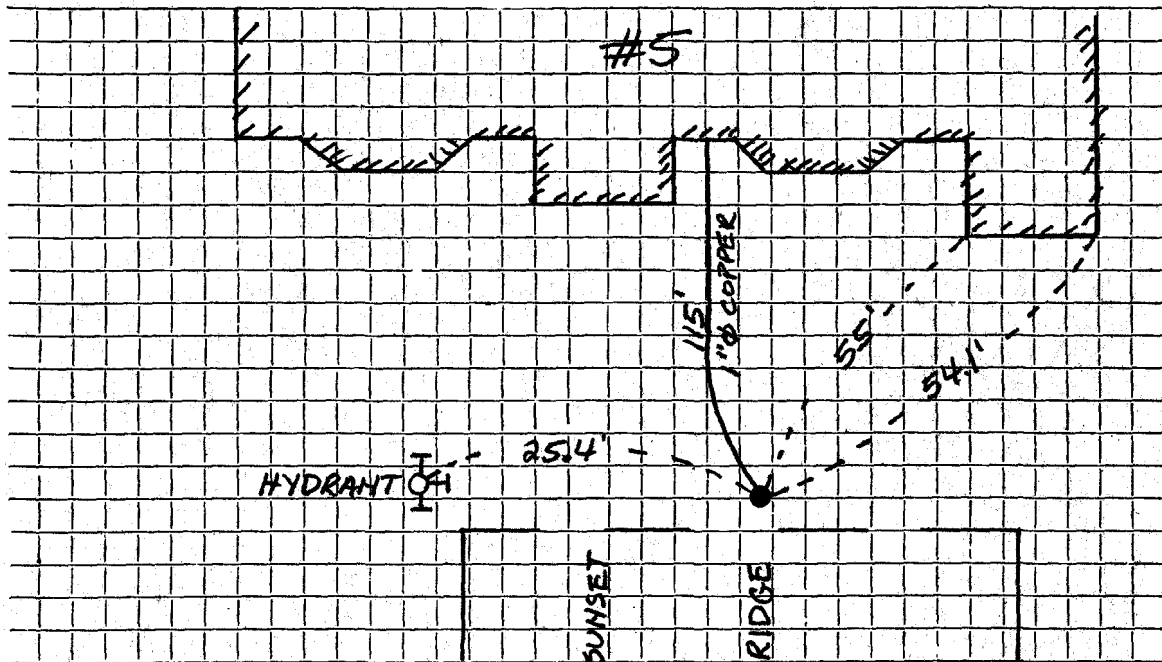

Connection made in SUNSET RIDGE Street. Work completed

Remarks: