

Name Waverley Const. Co.

1021

Service No. 95 3/95

Address 10 Sutherland Road

#4593

Lexington, Mass.

Location 10 Sutherland Road

Kind of Pipe

Size

Size of Main

~~Repair - Renewal~~ - New Service

Com. 12-16-46

Location

Date	Material	Amount	Total	Date	Location	Amount
Oct. 29, '46	Labor	1 10	1 10	Oct 22 '46	Deposited	15 00
	10% Overhead		11	Dec. 14 '46	Refunded	2 40
	34' - $\frac{3}{4}$ " Copper Tubing @.23		7 82		Non-Charge	12 60
	1 - $\frac{3}{4}$ " C x $\frac{1}{2}$ " I.W.H. S & W		2 82	Oct. 28, '46	Labor	1 10
	Trucking 1 hr. @.75		75	17' - $\frac{3}{4}$ " Copper Tubing @.23		3 91
	Trench Dug By Owner		12 60	1 - $\frac{3}{4}$ " C Corp-cock		2 70
				1 - $\frac{3}{4}$ " C x $\frac{3}{4}$ " C Curb-cock		3 30
				1 - Box & Rod		3 30
				1 - $\frac{1}{2}$ " Offset Tail Piece		50
				1 - $\frac{1}{2}$ " Straight Tail Piece		50
				Trucking 1 hr. @.75		75
						16 06
	Labor					

Hadley Press, Inc., Lexington

DATE \_\_\_\_\_

# TOWN OF LEXINGTON—BOARD OF PUBLIC WORKS

## WATER DIVISION

The undersigned applies for a supply of water at No. \_\_\_\_\_ St. and hereby agrees to comply with the rules and regulations as now, or at any future time, established by the Board of Selectmen.


Am't. of Estimate \$ \_\_\_\_\_

Owner \_\_\_\_\_

Am't. Paid \$ \_\_\_\_\_

Address \_\_\_\_\_

Builder \_\_\_\_\_

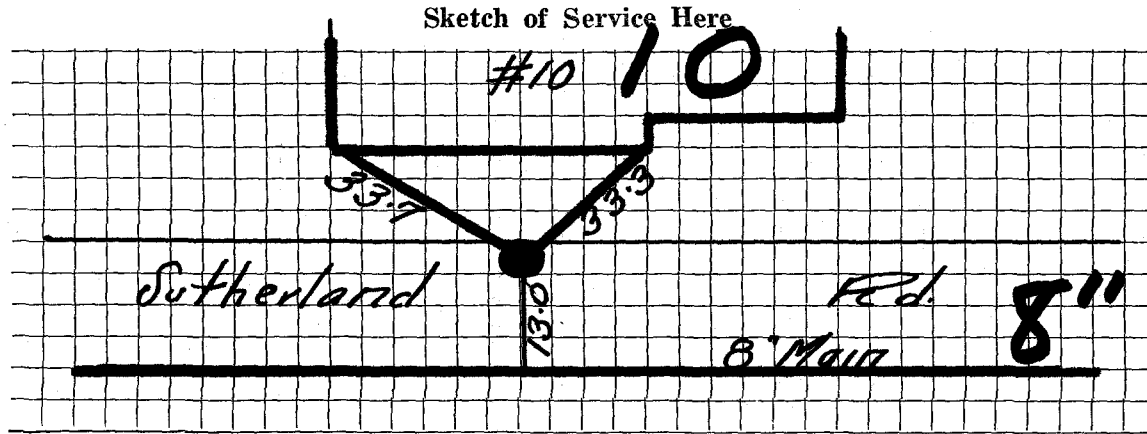

Connection made in \_\_\_\_\_ Street.

Work completed \_\_\_\_\_ 19

Remarks: