

Name Lexington, Homes, Inc.

Service No. ~~88~~ 2608

Address 57 Bedford Street, Lexington, Mass.

650

Location 15 Sutherland Road

#1015

Kind of Pipe

Size

Size of Main

Repair—Renewal—New Service

Location

Date 1941	Material	Amount	Total	Date	Location	Amount
Sept. 3, <i>Com 9/14/41</i>	2 hrs. @ 60¢	1 20		August 28, 1941	Deposited	17 00
	10% Overhead	<u>12</u>	1 32	September 16, 1941	Refunded	<u>5 60</u>
	32' 3/4" Copper tubing @ 19¢		6 08			11 40
	1 3/4" C.x. 1/2" I.S. & W.		2 50			
	2 hrs. trucking @ 75¢		<u>1 50</u>			
			11 40			
	Labor					

*Refund of \$5.60 to be credited
to sewer service #18.*

Hadley Press, Inc., Lexington

DATE August 21, 1941

TOWN OF LEXINGTON—BOARD OF PUBLIC WORKS

WATER DIVISION

The undersigned applies for a supply of water at No. 15 Lutherland Rd ^(Lot # 3) St. and hereby agrees to comply with the rules and regulations as now, or at any future time, established by the Board of Selectmen.

Am't. of Estimate \$ 17.-

Owner

Leungton Haines, Chas

Am't. Paid \$ _____

Address


57 Bedford St.

Builder _____

Leungton, Chas.

Lot. 0370

Sketch of Service Here

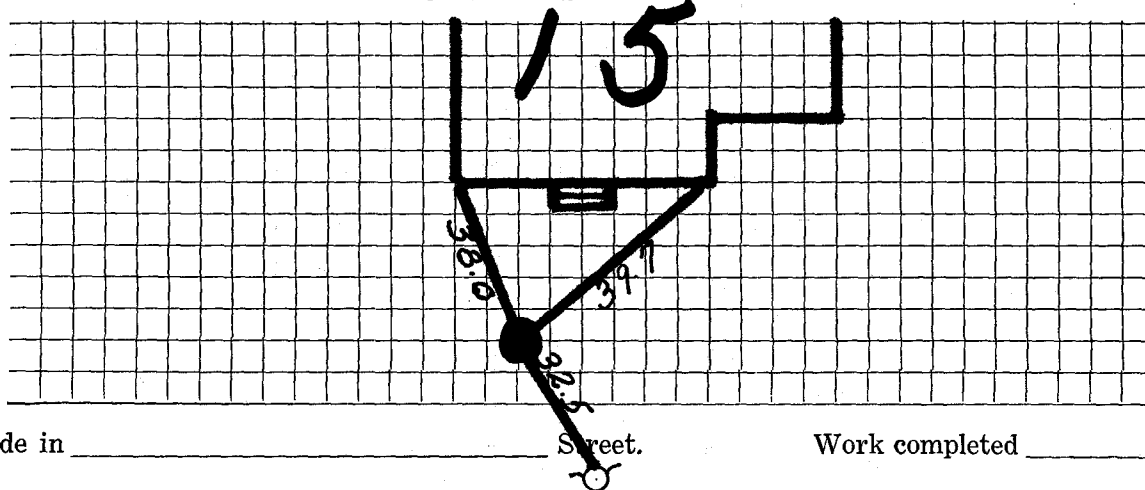

Connection made in _____ Street.

Work completed _____ 19

Remarks: