

Name Newall Const. Co.

Service No.

8253

Address 16 Sutherland Road

Lexington, Mass.

Location 16 Sutherland Road

Kind of Pipe



Size

Size of Main

~~Repair - Renewal~~ - New Service

Location

Date	Material	Amount	Total	Date	Amount
Mar. 29, '47	Labor	1 05	1 05	Mar. 25 '47	Deposited 20 00
	10% Overhead		11	May 22 '47	Refunded 4 86
	33' - $\frac{3}{4}$ " Copper Tubing @.27		8 91		Non-Charge 15 14
	1 - $\frac{3}{4}$ " C x $\frac{1}{2}$ " I.W.H. S & W		3 15	Mar. 29, '47	Labor 2 10
	1 - $\frac{3}{4}$ " C x $\frac{3}{4}$ " Union (3 pts)		1 17		12" $\frac{3}{4}$ " Copper Tubing @.27 3 24
	Trucking 1 hr. @.75		75		1 - $\frac{3}{4}$ " C. Corpcock 3 00
			15 14		1 - $\frac{3}{4}$ " C x $\frac{3}{4}$ " C Curb-cock 3 68
					1 - Box & Rod 3 35
					1 - $\frac{1}{2}$ " Straight Tail Piece 50
					1 - $\frac{1}{2}$ " Offset Tail Piece 50
					Trucking 1 hr. @.75 75
					17 12
	Labor				

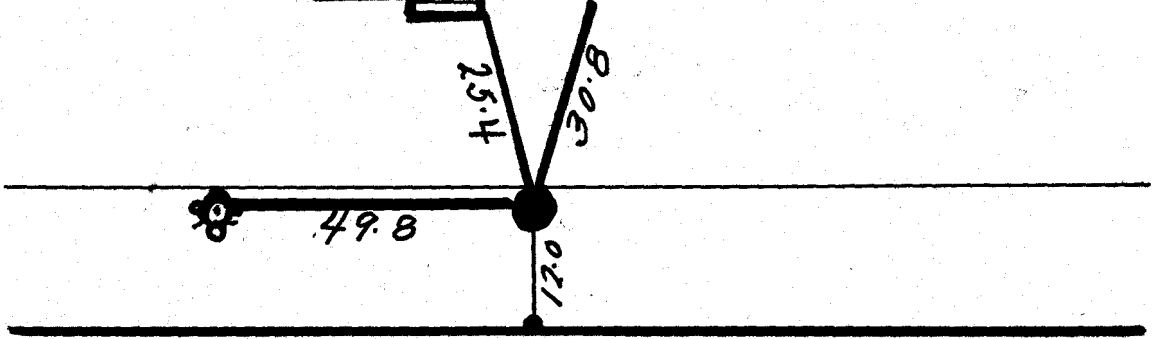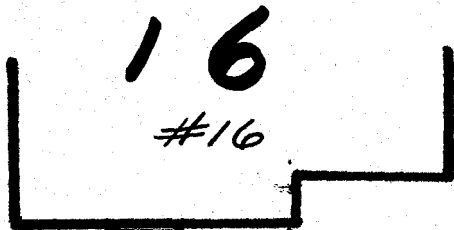

Sutherland

Rd.