

Name R. G. Fraser

Service No. 51 3150

Address 17 Sutherland Road

Lexington, Massachusetts Location 17 Sutherland Road

Kind of Pipe

Size

Size of Main

Repair—Renewal—New Service

Com. 9-23-46

Location

Date	Material	Amount	Total	Date	Amount
July 5, '46	Labor	90	90	June 29 '46	15 00
	10% Overhead		09	Oct 10 '46	4 32
	32' - 3/4" Copper Tubing @.1911	6 12			10 68
	1 - 3/4" C x 1/2" I.W.H. Stop & Waste	2 82		July 5, '46	1 80
	Trucking 1 hr. @.75		75	19' - 3/4" Copper Tubing @.1911	3 63
			10 68	1 - 3/4" C Corp-cock	2 70
				1 - 3/4" C x 3/4" C Curb-cock	3 30
				1 - Box & Rod	1 65
				1 - 1/2" Offset Tail Piece	90
				1 - 1/2" Straight Tail Piece	90
				Trucking 1 hr. @.75	75
					15 63
	Labor				

Hadley Press, Inc., Lexington

DATE _____

TOWN OF LEXINGTON—BOARD OF PUBLIC WORKS

WATER DIVISION

The undersigned applies for a supply of water at No. _____ St. and hereby agrees to comply with the rules and regulations as now, or at any future time, established by the Board of Selectmen.


Am't. of Estimate \$ _____

Owner _____

Am't. Paid \$ _____

Address _____

Builder _____

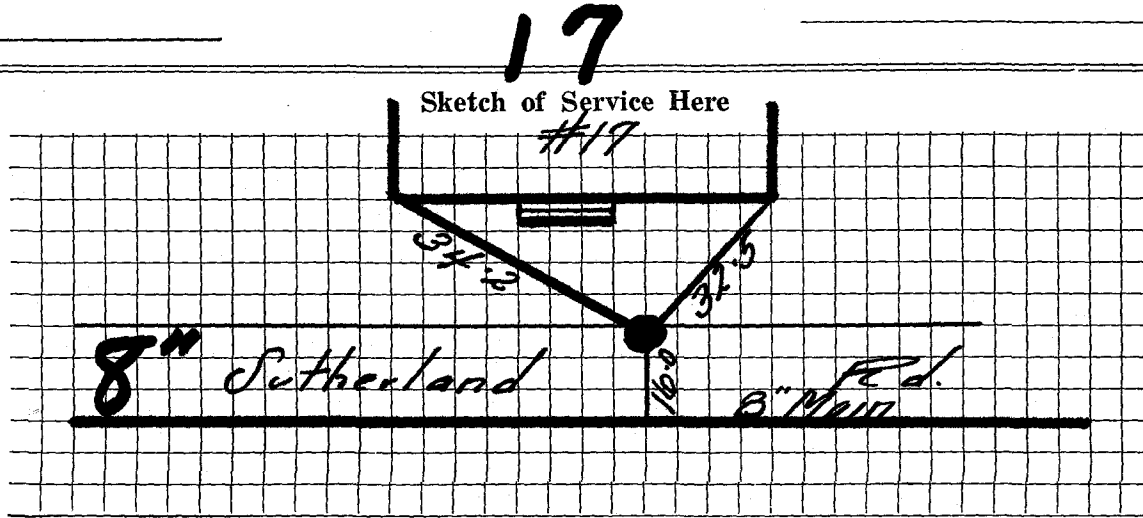

Connection made in _____ Street.

Work completed _____ 19

Remarks: