

Name Henry Crivelli

Service No.

52

Address 19 Sutherland Road

Lexington, Mass.

Location 19 Sutherland Road

Kind of Pipe

Size

Size of Main

~~XXXXXXXXXX~~ New Service

Com. 6-11-49

Location

Date	Material	Amount	Total	Date	Amount
Apr. 22, '49	Labor	1 25	1 25	April 11 '49	20 00
	10% Overhead		13	June 24 '49	5 67
	33' - 3/4" Copper Tubing @.27		8 91		14 33
	1 - 3/4" C x 1/2" I. W.H. S&W		3 29		
	Trucking 1 hr. @.75		75		
			14 33		
				Apr. 22, '49	1 25
					5 13
					3 15
					3 85
					3 95
					37
					37
					75
					18 82
	Labor				

DATE _____

TOWN OF LEXINGTON - BOARD OF PUBLIC WORKS

WATER DIVISION

The undersigned applies for a supply of water at No..... St. and hereby agrees to comply with the rules and regulations as now, or at any future time, established by the Board of Selectmen.

Am't of Estimate \$.....

Owner


Am't Paid \$.....

Address

Builder

.....

Sketch of Service Here

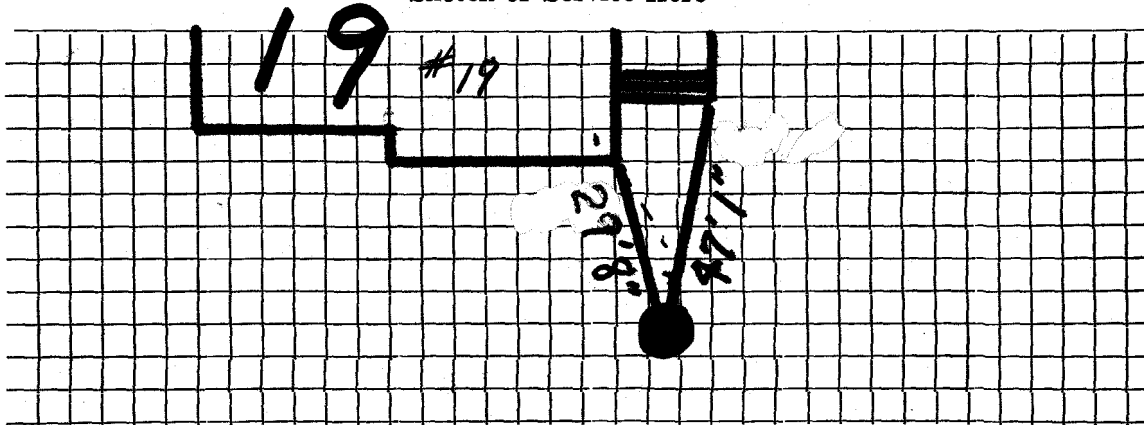

Connection made in Street.

Work completed19

Remarks: