

1613

Name Waverley Const. Co.

Service No. 96 3176

Address 7 Sutherland Road

7367

Lexington, Mass.

Location 7 Sutherland Rd.

Kind of Pipe

Size

Size of Main

~~Repairs - Branches~~ New Service

Com. 12-16-46

Location

Date	Material	Amount	Total	Date	Location	Amount
Oct. 30, '46	Labor	1 10	1 10	Oct 22 '46	Deposited	15 00
	10% Overhead		11	Dec 19 '46	Refunded	3 55
	29' - 3/4" Copper Tubing @.23		6 67		No-Charge	11 45
	1 - 3/4" C x 1/2" I.W.H. S. & W.		2 82	Oct. 20, '46	Labor	1 10
	Trucking 1 hr. @.75		75		23' - 3/4" Copper Tubing @.23	5 29
	<u>Trench Dug By Owner</u>		11 45		1 - 3/4" C Corp-cock	2 70
					1 - 3/4" C x 3/4" C Curb-cock	3 30
					1 - Box & Rod	3 30
					1 - 1/2" Offset Tail Piece	50
					1 - 1/2" Straight Tail Piece	50
					Trucking 1 hr. @.75	75
						17 44
	Labor					

Hadley Press, Inc., Lexington

DATE _____

TOWN OF LEXINGTON—BOARD OF PUBLIC WORKS

WATER DIVISION

The undersigned applies for a supply of water at No. _____ St. and hereby agrees to comply with the rules and regulations as now, or at any future time, established by the Board of Selectmen.


Am't. of Estimate \$ _____

Owner _____

Am't. Paid \$ _____

Address _____

Builder _____

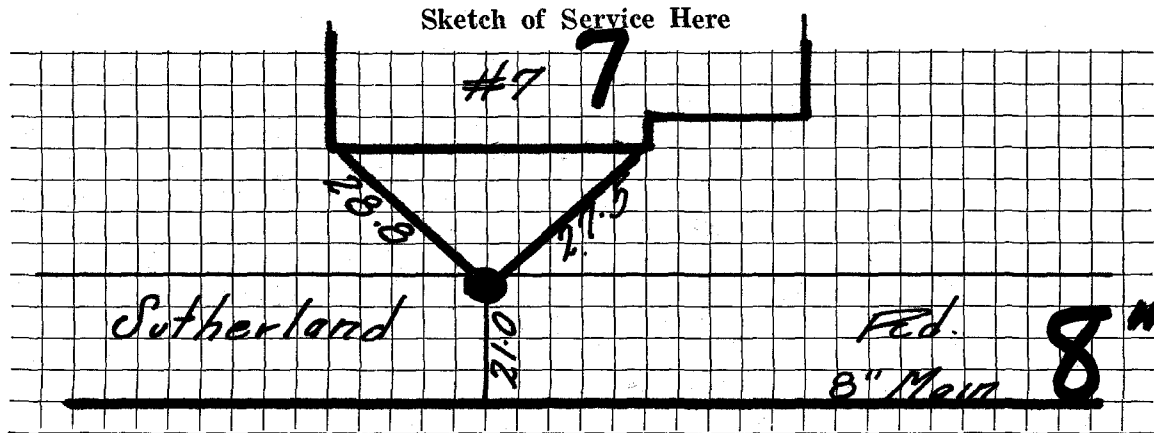

Connection made in _____ Street.

Work completed _____ 19

Remarks: