

WATER SERVICE RECORD

#3857

Name Ralph Frissore

Service No. 191

Address 9 Sutherland Road

Location

~~REPAIR SERVICE~~ - New Service

Comm 11-30-59

Date	Material	Amount	Total	Date	Amount
9-23-59	Labor	3.79		8-21-59	50.00
	10% O.H.	.38	4.17	11-30-59	23.62
38'	3/4" Copper tubing@ .41		15.58		26.38
1	3/4" C x 1/2 I.W.H. Stop&Waste		5.88		
1	Hr. Trucking@ .75		.75		
			26.38		
					NON CHARGE
					Labor
				22'	3/4" Copper tubing@ .41
				1	3/4" C Corp Cock
				1	3/4" C Curb Cock
				1	Box & Rod
				1	1/2 Straight tailpiece
				1	1/2 Offset tailpiece
					29.46


Applied to SF# 191 (9.56)

DATE \_\_\_\_\_

TOWN OF LEXINGTON — BOARD OF PUBLIC WORKS

**WATER DIVISION**

Sketch of Service Here

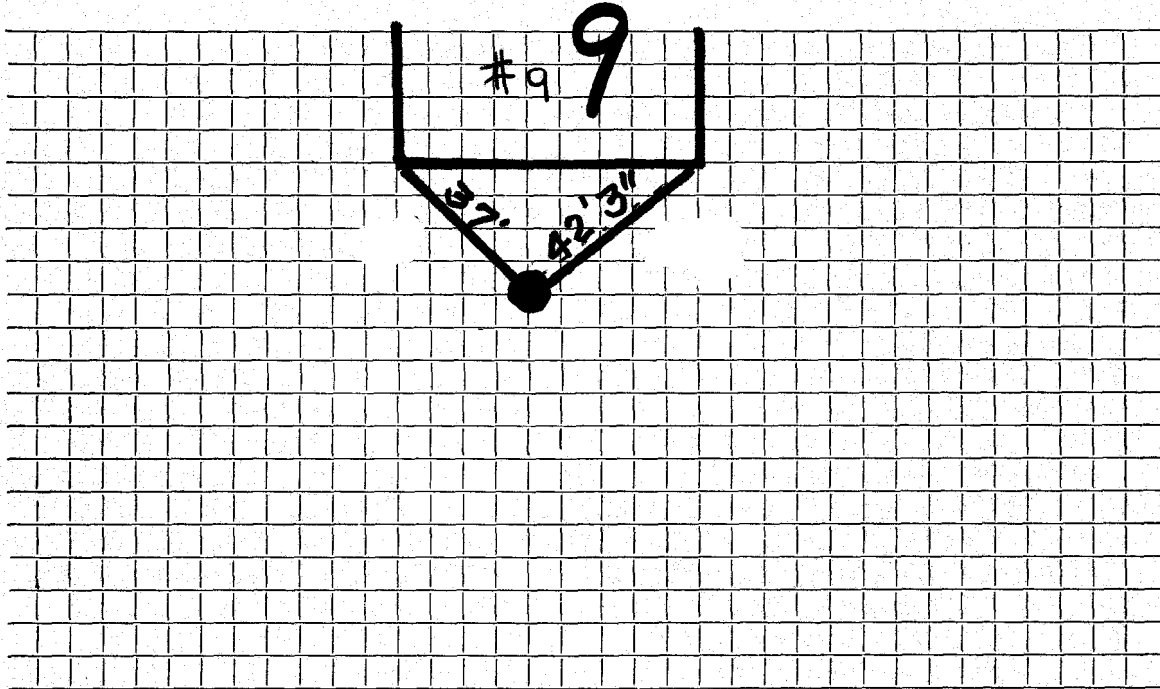

Connection made in ..... Street. Work completed .....

Remarks: .....  
.....  
.....