


DATE 6/13/18

TOWN OF LEXINGTON — BOARD OF PUBLIC WORKS
WATER DIVISION

Sketch of Service Here

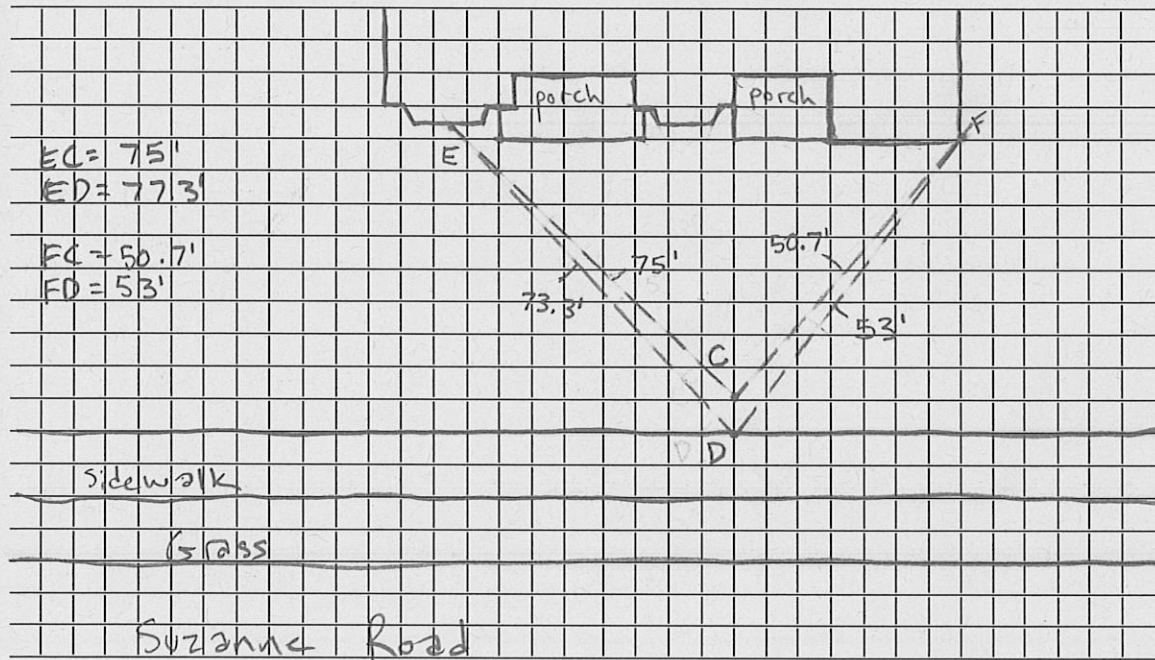

EC = 75'
ED = 77.3'
FC = 50.7'
FD = 53'

Connection made in Suzanne Street. Work completed

Remarks: C = open right curb stop with buffalo box, D = 3/4" to 1" union

Depth of curb stop = 6.5' Bedded in sand, warning tape, 1" Cu pipe.