

WATER SERVICE RECORD

3279

Name John Castoldi

Service No.

Address 24 Suzanne Road


Location Lot 11 Sta. 15+66 J.M.Lucente Permit #103

Repair, Renewal—New Service **SERVICE BY BUILDER**

DATE _____

TOWN OF LEXINGTON — BOARD OF PUBLIC WORKS
WATER DIVISION

Sketch of Service Here

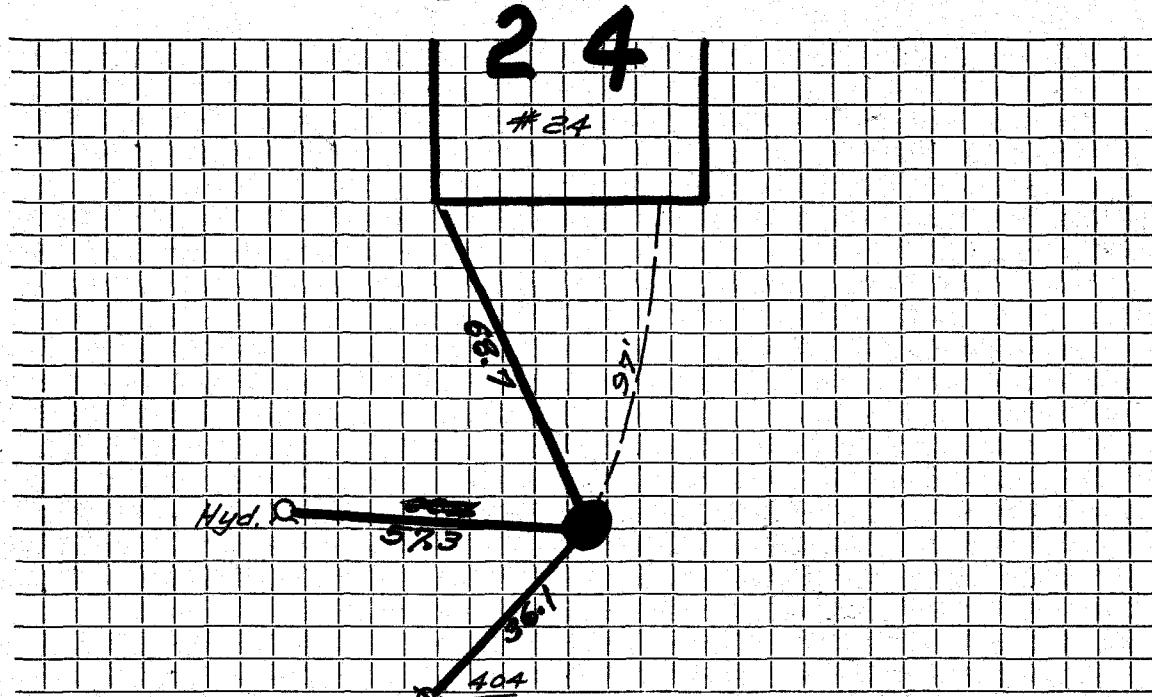

Connection made in Street. Work completed

Remarks: