


DATE 05/14/24

TOWN OF LEXINGTON — BOARD OF PUBLIC WORKS
WATER DIVISION

Sketch of Service Here
3 #3 Suzanne Rd

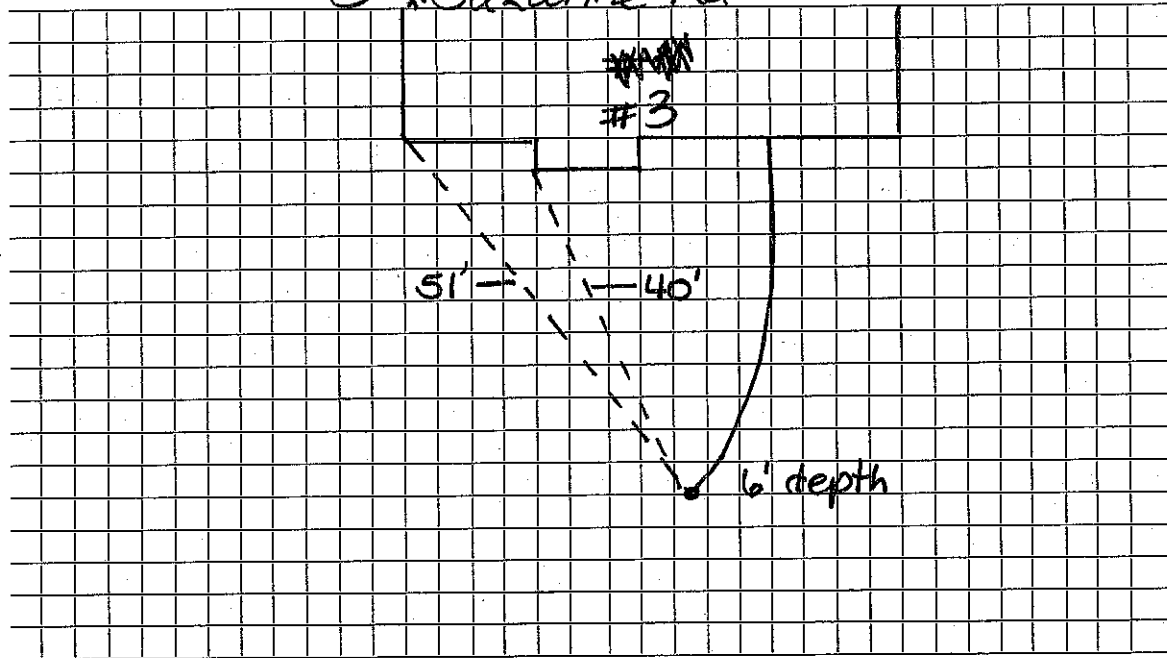

Connection made in Suzanne Rd Street. Work completed Speedwagon

Remarks: