

WATER SERVICE RECORD

#2917

Name John Castoldi

Service No. 97

Address #4 Suzanne Road

Location Lot 6

Repair—Renewal—New Service

WO# 2494

Comm 10-29-62


Date	Material	Amount	Total	Date	Amount	
8/22/62	Labor	15 88		7-30-62	Deposit	100 00
	10% O.H.	1 59		10-29-62	Re-Summed	33 73
			17 47			66 27
	66' 3/4" copper tubing @.42		27 72		NON CHARGE	
	1" 3/4" Cx 1/2 IWH Stop & Waste		6 17	1/3/58	Labor	4 17
	1 3/4" C3 part Union		2 41	15' 3/4" Copper Tubing @ .37		5 55
	1 hr. Town shovel @ 6.50		6 50	1 3/4" G Corp Cock		4 64
	1 hr. trucking @ 3.00		3 00	1 3/4" G Curb Cock		6 03
	1 hr. Loader @ 3.00		3 00	1 Box & Rod		5 00
			66 27	1 Hour Trucking @ 75		8 75
				1 1/2 straight tail piece		26 14
				1 1/2 offset tail piece		50
						27 14

DATE _____

TOWN OF LEXINGTON — BOARD OF PUBLIC WORKS

WATER DIVISION

Sketch of Service Here

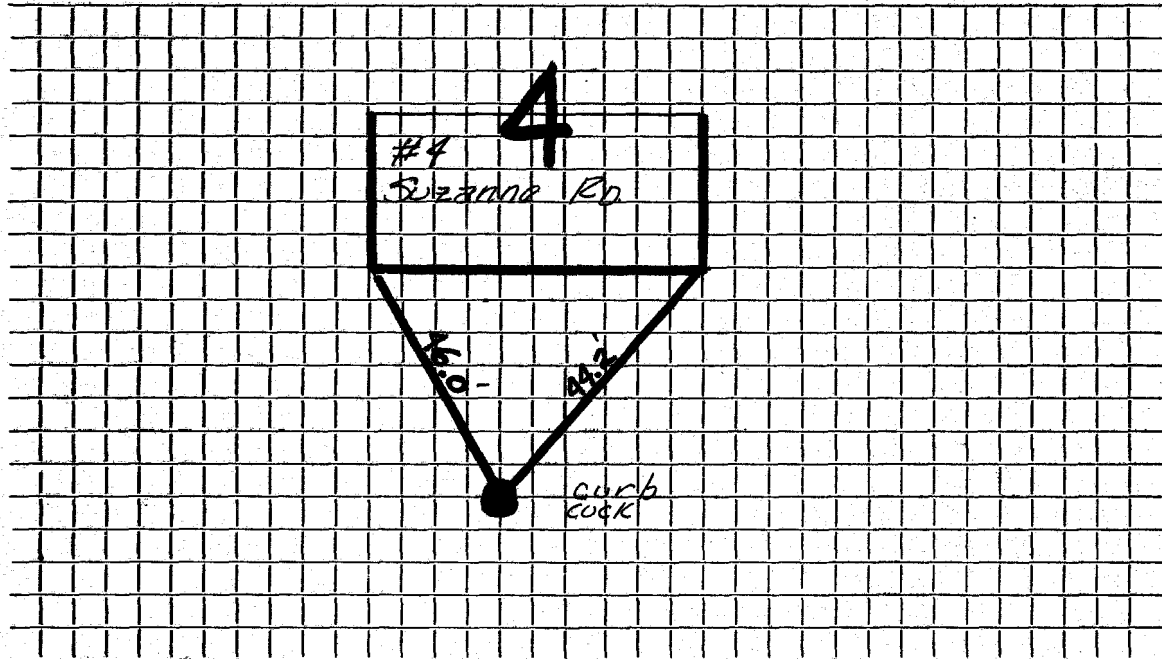

Connection made in Street. Work completed

Remarks:

.....

.....